

ADDENDUM NO. 2

To the Drawings and/or the Specifications for
Harford County Public Schools
Harford High School
Comprehensive Roof Replacement – CAG 25-1
Bel Air, Maryland

Gilbert Architects Inc.
626 N. Charlotte St.
Lancaster, PA 17603
(717) 291-1077

April 7, 2026

Project Manager: Kevin McCandless

Revisions and modifications contained in this Addendum supersede the previously issued Documents for the above referenced Project.

ARCHITECTURALDRAWINGS

1. Delete “PROGRESS SET” and “NOT FOR CONSTRUCTION” from title blocks of all drawings.
2. SHEETS A4.1 – ROOF PLAN – DEMOLITION and A4.2 – ROOF PLAN, LEGEND, AND NOTES:
RFI Question: “Architectural demolition drawing A4.1 indicates removal of roof drain and overflow pipe. However new work on A4.2 only identifies a new roof drain. Please clarify if overflow drains or overflow pipes are to be installed as part of the new work.
RFI Response: Primary drains that have overflow drains and those that don’t have overflows are identified with different demo tags and notes on the demo drawings, and different roof drain tags and notes on the new work roof plan. Refer to the demolition notes on sheet A4.1, and the roof plan legend on A4.2. There are a few corrections to the roof drains on the demolition drawings and the drains on the new work roof plan. See the revised sheets A4.1 and A4.2 included herein for these corrections.
3. **RIF Question:** Is the R Value minimum average per section or average across the project?
RIF Response: Areas of the roof with ¼” per ft. existing sloped structure shall receive a minimum R-30 insulation. Areas of the roof with 1/8” per ft. sloped structure shall receive a tapered layout adding an additional 1/8” per ft. slope to provide an average R-30 R Value. Areas with level roof structure will receive a ¼” per ft. tapered layout to provide an average R-30 R Value. Refer to the manufacturer’s tapered layout on Sheet A4.10 and the roof Assembly Types on Sheet A4.2 for this information.
4. **RFI Question:** Per Section 070150-2 2.6 D, are hazardous materials expected to be found on this project that you may be aware of, to include pitch in asphalt products that may have been previously used?
RFI Response: No hazardous materials area anticipated due to the age of the most recent roof projects that were completed. If any hazardous materials are encountered, see procedures included in the specifications.
5. **RFI Question:** Are there utilities available to hook up an office trailer?
RFI Response: An electrical hook up can be considered. No water or sewer is available.
6. **RFI Question:** Is fencing required for staging area for materials?
RFI Response: Fencing of staging areas is at the contractors’ discretion.

MECHANICAL SPECIFICATIONS

7. ADD RDR-2 to Specification Section 224005 PLUMBING EQUIPMENT, Paragraph 2.1.E.2
8. ADD Trane and remove Petra Engineering Industries to Specification Section 230600 HEATING VENTILATING AND AIR CONDITIONING EQUIPMENT, Paragraph 2.1.A.1.
9. ADD Trane and United Cool Air and remove Petra Engineering Industries to Specification Section 230600 HEATING VENTILATING AND AIR CONDITIONING EQUIPMENT, Paragraph 2.2.A.1.

MECHANICAL DRAWINGS

1. ADD Drawing Note 3 to Drawing 1.0 that reads "RX Secondary Roof Drain".
2. REVISE ERV-7 on Drawing M1.1.
3. ADD Rooftop Ductwork Notes to Drawing M2.0.
4. ADD Drawing Note 2 to Drawing 2.0 that reads "INSTALL SECONDARY ROOF DRAIN. PROVIDE ANY PIPE MODIFICATIONS REQUIRED TO CONNECT ROOF DRAIN OUTLET TO EXISTING STORM WATER PIPING. SEE ARCHITECTURAL DETAILS FOR ADDITIONAL INFORMATION.
5. REVISE ERV-7 on Drawing M2.1.
6. ADD DRAWING M4.1.

ELECTRICAL DRAWINGS

1. ADD key plans to electrical drawings included herein.

PRE-BID RFIs

1. **RFI Question:** "For both the demolition work and new work in the mechanical rooms, no housekeeping pads are shown as demolished/modified or new. Please confirm this is correct."
RFI Response: Housekeeping pads are existing to remain.
2. **RFI Question:** "Specifications 230505 2.1 pipe materials indicate 1 ½" and smaller pipe as SCH40 BLK Steel with threaded fitting and 2" and larger as SCH 40 BLK Steel with weld fittings. Please confirm this is correct for the new work as copper pipe and fittings are normally used for 2" and smaller on these projects."
RFI Response: Copper pipe and fittings are acceptable for pipe sizes 2" and smaller. Copper piping shall be type L (ASTM Std. B88) with wrought copper fittings (ASTM Std. B 16.22) with brazed or 95-5 silver solder joints.
3. **RFI Question:** Under ROOFTOP ENERGY RECOVERY VENTILATORS: Can Trane be added as an approved manufacturer?
RFI Response: Trane is an acceptable manufacturer.
4. **RFI Question:** Under INDOOR ENERGY RECOVERY VENTILATORS: Can Trane be added as an approved manufacturer?
RFI Response: Trane is an acceptable manufacturer.

END OF ADDENDUM NO. 2

SECTION 22 40 05
PLUMBING EQUIPMENT

PART 1 - GENERAL

1.1. RELATED DIVISIONS AND SECTIONS

- A. The Conditions of the Contract and other General Requirements apply to the work specified in this section. All work under this section shall also be subject to the requirements of Division 23 Section, "*Common Work Results for HVAC*".
- B. DIVISION 01 – GENERAL REQUIREMENTS, GENERAL CONDITIONS AND SUPPLEMENTARY CONDITIONS
- C. DIVISION 03 – CONCRETE
- D. DIVISION 05 – METALS
- E. DIVISION 06 – WOOD, PLASTIC AND COMPOSITES
- F. DIVISION 07 – THERMAL AND MOISTURE PROTECTION
- G. DIVISION 22 – PLUMBING
- H. DIVISION 26 – ELECTRICAL
- I. Ensure products and installation of specified products are in conformance with recommendations and requirements of the following organizations:
 - 1. American Gas Association (AGA).
 - 2. American Society of Mechanical Engineers (ASME).
 - 3. American National Standards Institute (ANSI).
 - 4. National Electrical Manufacturers' Association (NEMA).
 - 5. National Sanitation Foundation (NSF).
 - 6. Underwriters Laboratories (UL).

1.2. SUMMARY

- A. Provide all labor and materials necessary to furnish and install all systems and equipment on this project as herein specified and/or shown on the drawings. Final connections to equipment furnished in other sections of the specifications shall be included under this section.
- B. Installation shall comply with manufacturer's recommendations.
- C. Installations shall comply with all local plumbing codes and amendments.
- D. Use unions, flanges, and couplings downstream of valves and at equipment or apparatus connections. Do not use direct welded or threaded connections to valves, equipment or other apparatus.
- E. Use non-conducting dielectric connections whenever jointing dissimilar metals in open systems.
- F. At all runout piping serving equipment, use swing joints with elbows to prevent excessive movement of piping due to expansion.
- G. All exposed bolts, screws, etc., shall be vandal proof.
- H. Provide shutoff valves for each piece of equipment and the valves shall be fully accessible.
- I. Verify that field measurements are as indicated on shop drawings and per the manufacturer.

1.3. SUBMITTALS

- A. Submit in accordance with Division 01 and Division 22.
- B. Provide parts list and assembly drawings (exploded view) for all valves in shop drawing submittals. Provide valves of the same type by the same manufacturer.
- C. Provide UL label on electric powered equipment or certification that the equipment has been tested by a testing agency approved by local authority and is equivalent in safety to UL labeled equipment.
- D. ALTERNATES
Refer to Division 01 Section, "ALTERNATES" for description of work under this division affected by alternates.

1.4. DELIVERY, STORAGE, AND HANDLING

- A. Deliver, store, protect and handle products to site under provisions of General Requirements.
- B. Accept equipment on site in factory packaging. Inspect for damage.
- C. Provide temporary end caps and closures on piping connection to equipment. Maintain in place until installation.
- D. Protect installed equipment from damage by securing areas and by leaving factory packaging in place to protect equipment and prevent use.

PART 2 - PRODUCTS

2.1. ROOF DRAINS

- A. Provide flashing clamps on all drains penetrating waterproofing membrane.
- B. Provide suitable flashing material and clamping collar for drains which are not set in-place when slab is poured.
- C. Provide Josam 26200 vertical expansion joint in each rain leader that does not have 90 degrees offset downstream of the roof drain. The expansion sleeve shall be bronze and shall conduct the rain water beyond the packing. Install expansion joints in accessible locations for repacking.
- D. In lieu of joints specified in piping section, neoprene gaskets may be used if designed for use with the drains and cleanouts employed and if approved by the local plumbing authority.
- E. Schedule of Drains and Accessories:
 - 1. RDR-1 – Roof Drain: Josam 21500-AE-26 15-inch diameter roof drain, dura coated cast iron body with combination membrane flashing clamp/gravel guard and low silhouette aluminum locking dome. Provide with support ring, adjustable top with wide roof flange, large sump with anchor flange, bottom outlet inside caulk connection and deck clamp.
 - 2. **RDR-2: Overflow Roof Drain**: **Zurn Z-100 15 " diameter roof drain, dura coated cast iron body with combination membrane flashing clamp/gravel guard and low silhouette aluminum locking dome. Provide with support ring, adjustable top with wide roof flange, large sump with anchor flange, bottom outlet inside caulk connection and deck clamp. Provide 2" internal water dam. ADD #2**

PART 3 - EXECUTION

3.1. GENERAL INSTALLATION REQUIREMENTS

- A. Coordinate with architectural drawings before roughing in plumbing.
- B. Install equipment plumb and level.

- C. Coordinate with plumbing piping work to achieve a complete operating system.
- D. Provide final connections to equipment even though all branch mains, elbows and connections are not shown.

3.2. DRAINS

- A. Provide where indicated on the drawings and install in accordance with manufacturer's recommendations, architectural and plumbing drawings.
- B. Unless otherwise noted, drains are to be installed at the low point roof, etc. Protect drains during remainder of construction period to avoid clogging with dirt and debris and to prevent damage from traffic and construction work.
- C. Drains not functioning properly shall be removed and re-installed properly at the expense of the contractor.
- D. Coordinate cutting and forming of roof construction to receive drains to required invert elevations. Roof drain bodies shall be installed below finished roof elevation.

3.3. TESTING

- A. After the building has been occupied and the various equipment is in actual use, the Contractor shall make an operating test of all equipment at a time directed by the Engineer to determine that all contract requirements are met.


3.4. PREPARATION

- A. Rough-in fixture piping connections in accordance with minimum sizes indicated in fixture rough-in schedule for particular fixtures.

3.5. CLEANING

- A. At the completion of the project, clean the plumbing equipment.

END OF SECTION

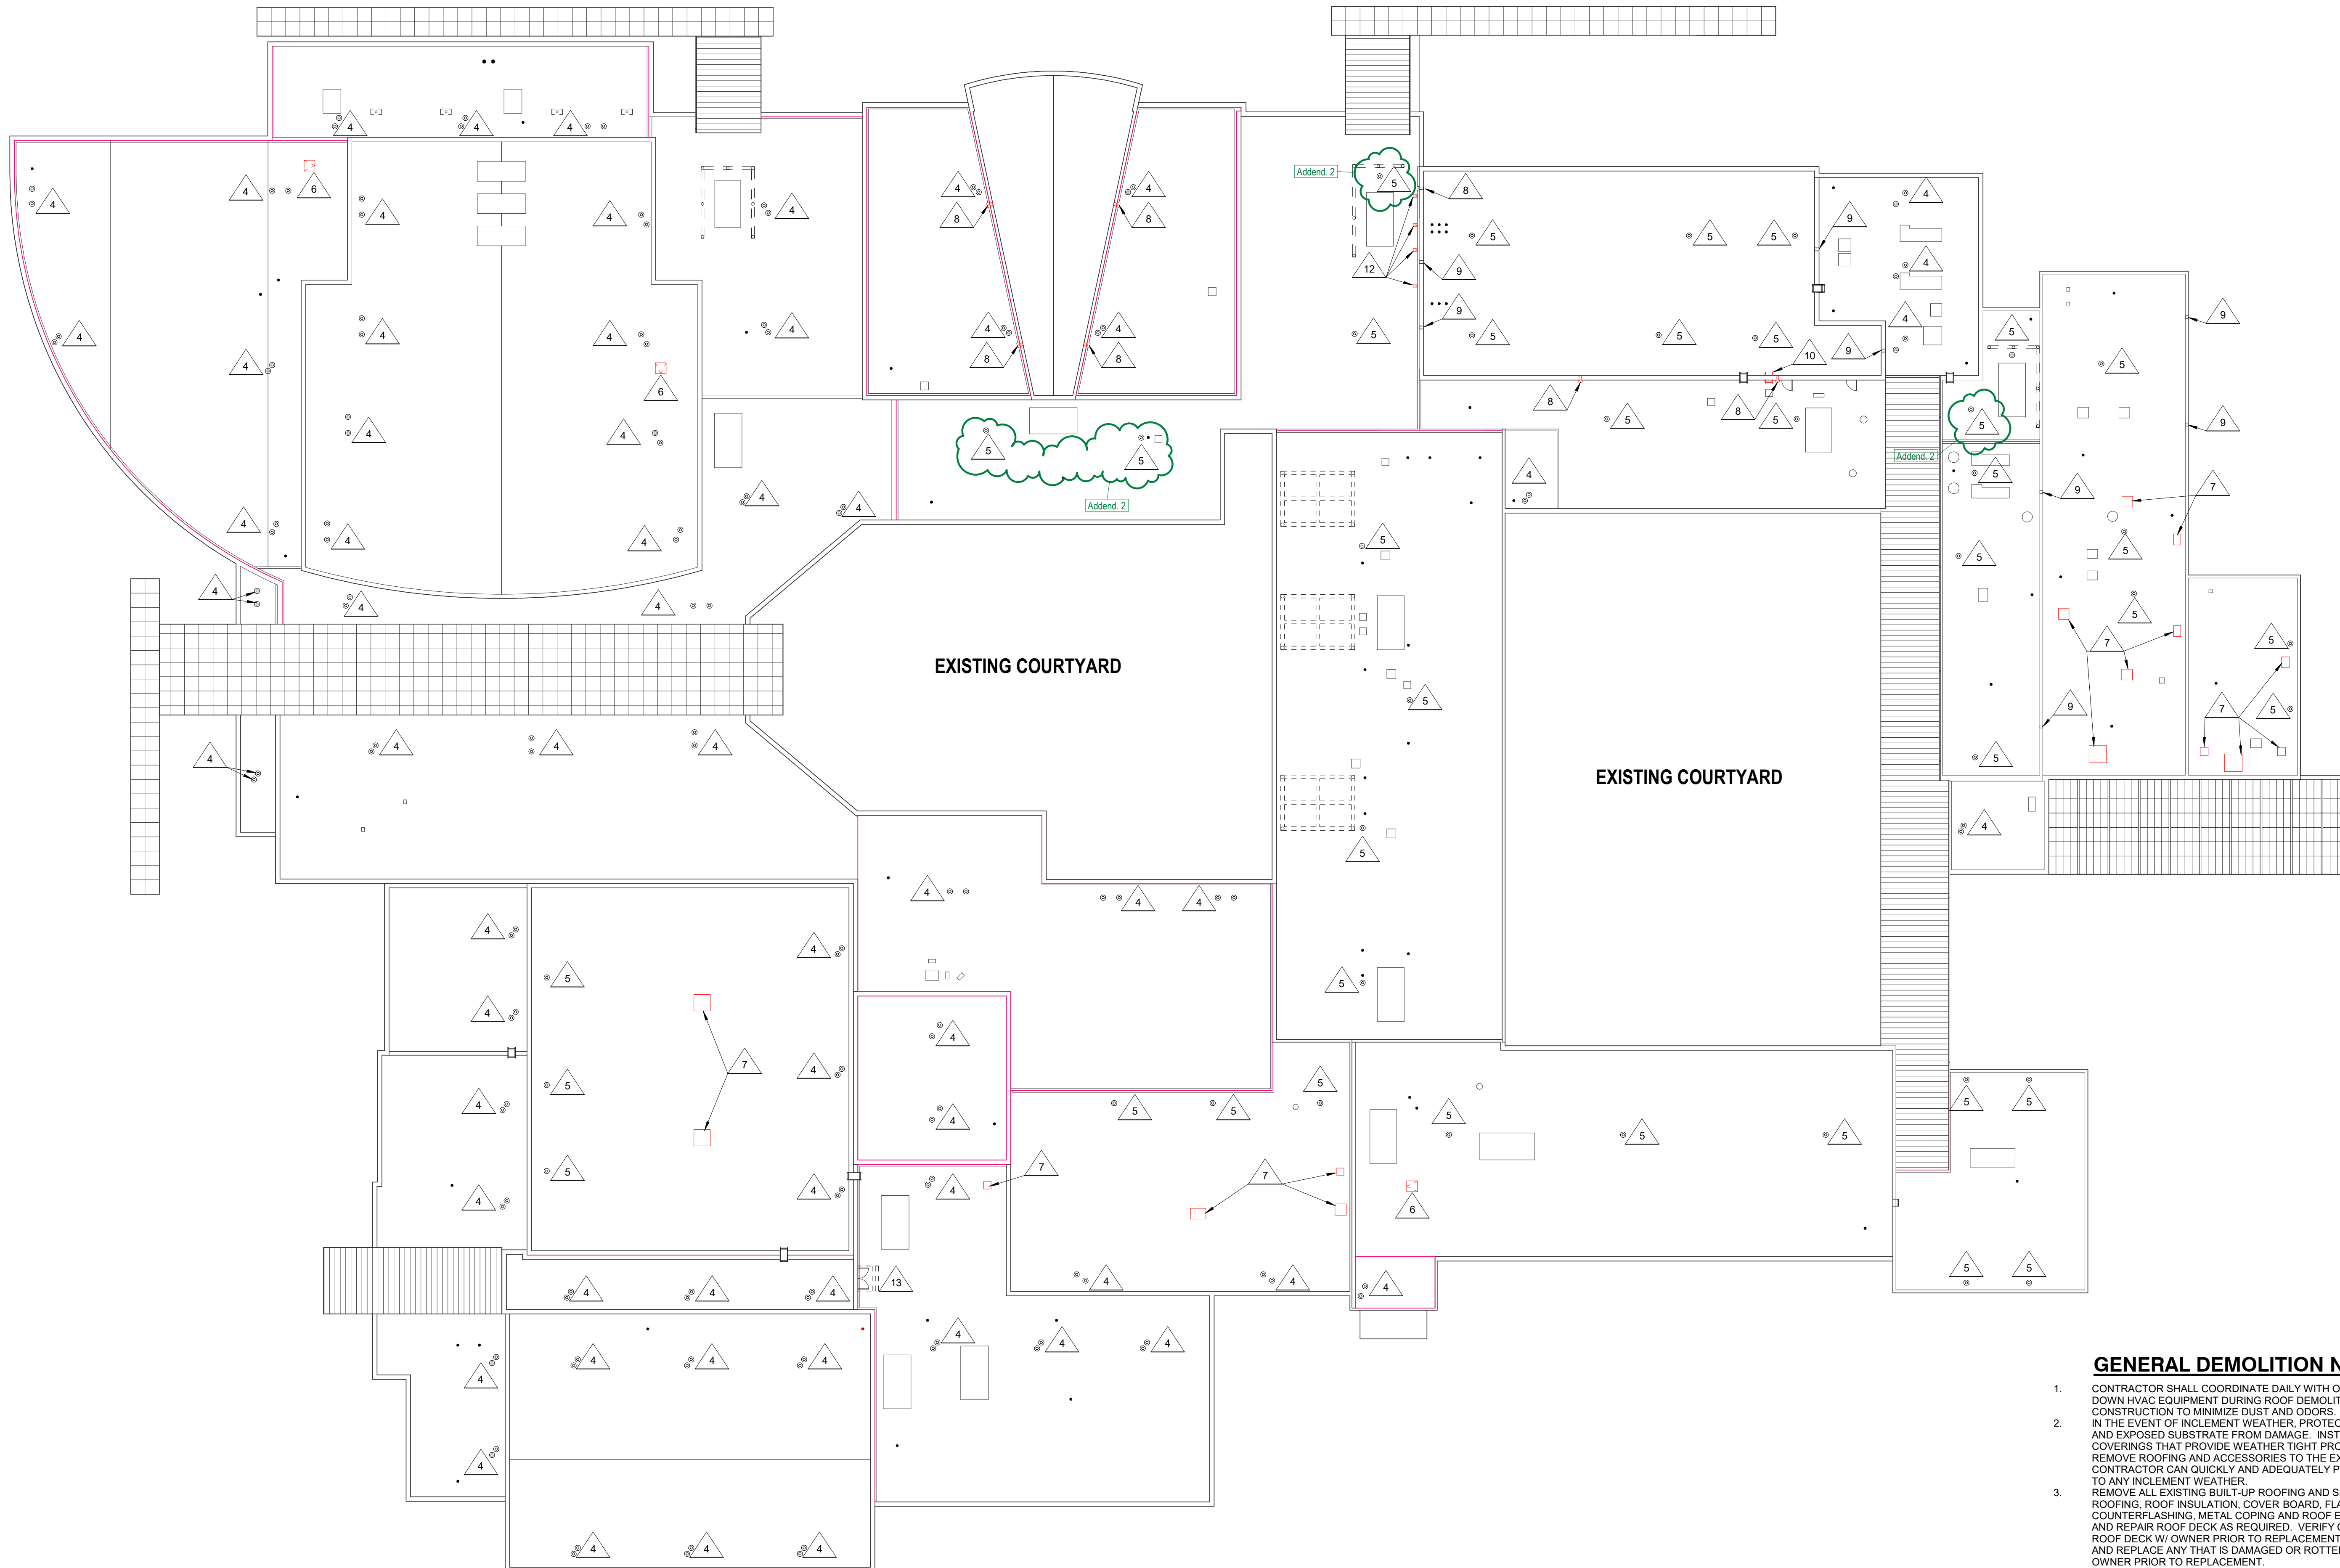

1 OVERALL ROOF PLAN
 A4.1
 3/8" = 1'-0"
 0' 10' 21' 42'

GENERAL DEMOLITION NOTES


- CONTRACTOR SHALL COORDINATE DAILY WITH OWNER TO SHUT DOWN HVAC EQUIPMENT DURING ROOF DEMOLITION AND NEW CONSTRUCTION TO MINIMIZE DUST AND ODORS.
- IN THE EVENT OF INCLEMENT WEATHER, PROTECT ROOF OPENINGS AND EXPOSED SUBSTRATE FROM DAMAGE. INSTALL TEMPORARY COVERINGS THAT PROVIDE WEATHER TIGHT PROTECTION. ONLY REMOVE ROOFING AND ACCESSORIES TO THE EXTENT THAT THE CONTRACTOR CAN QUICKLY AND ADEQUATELY PROTECT WORK PRIOR TO ANY INCLEMENT WEATHER.
- REMOVE ALL EXISTING BUILT-UP ROOFING AND SINGLE PLY MEMBRANE ROOFING, ROOF INSULATION, COVER BOARD, FLASHING, METAL COUNTERFLASHING, METAL COPING AND ROOF EDGE METAL U.N.O. INSPECT AND REPAIR ROOF DECK AS REQUIRED. VERIFY QUANTITY OF ANY DAMAGED ROOF DECK W/ OWNER PRIOR TO REPLACEMENT. INSPECT WOOD BLOCKING AND REPLACE ANY THAT IS DAMAGED OR ROTTED. VERIFY QUANTITIES W/ OWNER PRIOR TO REPLACEMENT.

DEMOLITION PLAN NOTES

- REMOVE ROOF DRAIN AND STRAINER. PREP. FOR NEW DRAIN. REMOVE PORTION OF EXISTING CEILING TILE BELOW WHERE REQUIRED FOR INSTALLATION OF NEW DRAIN. REINSTALL CEILING TILE UPON COMPLETION OF NEW DRAIN WORK. PREPARE EXISTING OVERFLOW DRAIN PIPE AS REQUIRED TO RECEIVE NEW OVERFLOW DRAIN AND STRAINER.
- REMOVE ROOF DRAIN AND STRAINER. PREP. FOR NEW DRAIN. REMOVE PORTION OF EXISTING CEILING TILE BELOW WHERE REQUIRED FOR INSTALLATION OF NEW DRAIN. REINSTALL CEILING TILE UPON COMPLETION OF NEW DRAIN WORK.
- REMOVE ROOF ACCESS HATCH. PREPARE OPENING FOR NEW ACCESS HATCH. EXISTING LADDER TO REMAIN. SEE DETAILS 8 & 71A4.8.
- REMOVE EXISTING EQUIPMENT CURB NO LONGER IN USE. REMOVE METAL CAP. SEE DETAIL.
- REMOVE SCUPPER SLEEVE, CONDUCTOR HEAD, AND DOWNSPOUT NO LONGER IN USE. COVER OPENING ON WALL WITH S.S. PLATE SET IN CONT. SEALANT.
- REMOVE SCUPPER SLEEVE. SEE DETAIL 12/A4.3 FOR NEW SCUPPER DETAIL.
- REMOVE ROOF LADDER. PATCH FASTENER HOLES WITH SHEET METAL. PAINTED TO MATCH COLOR OF EXISTING METAL PANEL SIDING.
- REMOVE EXISTING WEATHER STATION AND RELOCATE WHERE INDICATED. SEE NOTE 17 ON ROOF PLAN 1/A4.2.
- REMOVE EXISTING STEEL POSTS AND FLASHING DOWN TO EXISTING ROOF DECK.
- REMOVE EXISTING STEEL STAIR AND RAILINGS. PATCH EXISTING WALL AS REQUIRED. REMOVE SUPPORT POSTS DOWN TO ROOF DECK.

SYMBOL KEY
 1 = DEMOLITION TAG ON PLAN (SEE DEMOLITION PLAN NOTES FOR DEFINITION OF TAG NUMBERS)

Gilbert Architects retains all ownership, copyright, and other rights in the drawings and information contained herein. The recipient warrants that the drawings and information are to be used only for the project and site identified herein and that the recipient will not use the drawings or information for any other project or site without the permission of Gilbert Architects.

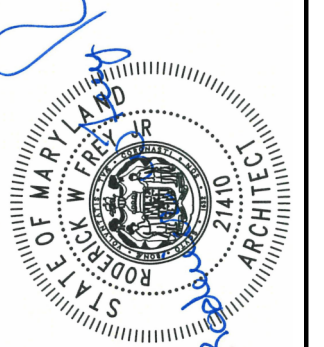

Professional Certification:
 I hereby certify that these drawings were prepared by me or approved by me, and that I am a duly licensed Professional Engineer of the State of Maryland.
 License No. 24111
 Expiration Date: 12/31/2027

638 North Chaucers Street
 P.O. Box 1077
 P 717 291-1077
 200 Commercial Drive, Suite 401
 P 302 335-1500
 P 302 335-1500
 14655 Mt. Airy, Suite 400
 Owings Mills, MD 21117
 P 410 350-8866




ROOF PLAN - DEMOLITION
 COMPREHENSIVE ROOF REPLACEMENT TO:
 NORTH HARFORD HIGH SCHOOL
 PYLESVILLE, MARYLAND 21132
 HARFORD COUNTY PUBLIC SCHOOLS

REVISION	DATE
Addendum 2	04/07/25

DRAWN BY: TJA
 PROJECT NO.: 2511
 SHEET NO.:

A4.1
 DATE: 03/15/2025

Gilbert Architects retains all ownership, copyright, and other rights in the drawings and information contained herein. The receiver warrants that the drawings and information are to be used only for the project and site identified herein and that any other use without the permission of Gilbert Architects.

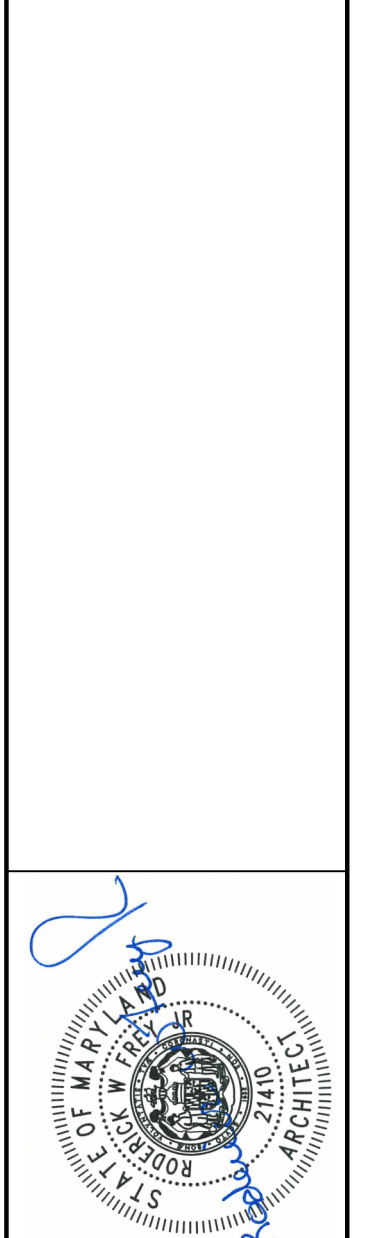

Professional Certification: I hereby certify that these drawings were prepared by me or approved by me, and that I am a duly licensed Professional Engineer of the State of Maryland. License No. 14111, State of Maryland, Commission on Professional Registration, Expiration Date 12/30/2027.


638 North Charesse Street
P.O. Box 117
P. 717.291.1077
200 Continental Drive, Suite 401
P. 302.315.1500
14645 Millersville Road, Suite 400
Owings Mills, MD 21117
P. 410.350.8866



ROOF PLAN, LEGEND, AND NOTES
COMPREHENSIVE ROOF REPLACEMENT TO:
NORTH HARFORD HIGH SCHOOL
PYLESVILLE, MARYLAND 21132
HARFORD COUNTY PUBLIC SCHOOLS

REVISION	DATE
2	6/6/2025

DRAWN BY: TJA/HOM
PROJECT NO: 2511
SHEET NO:
A4.2
DATE: 03/15/2025

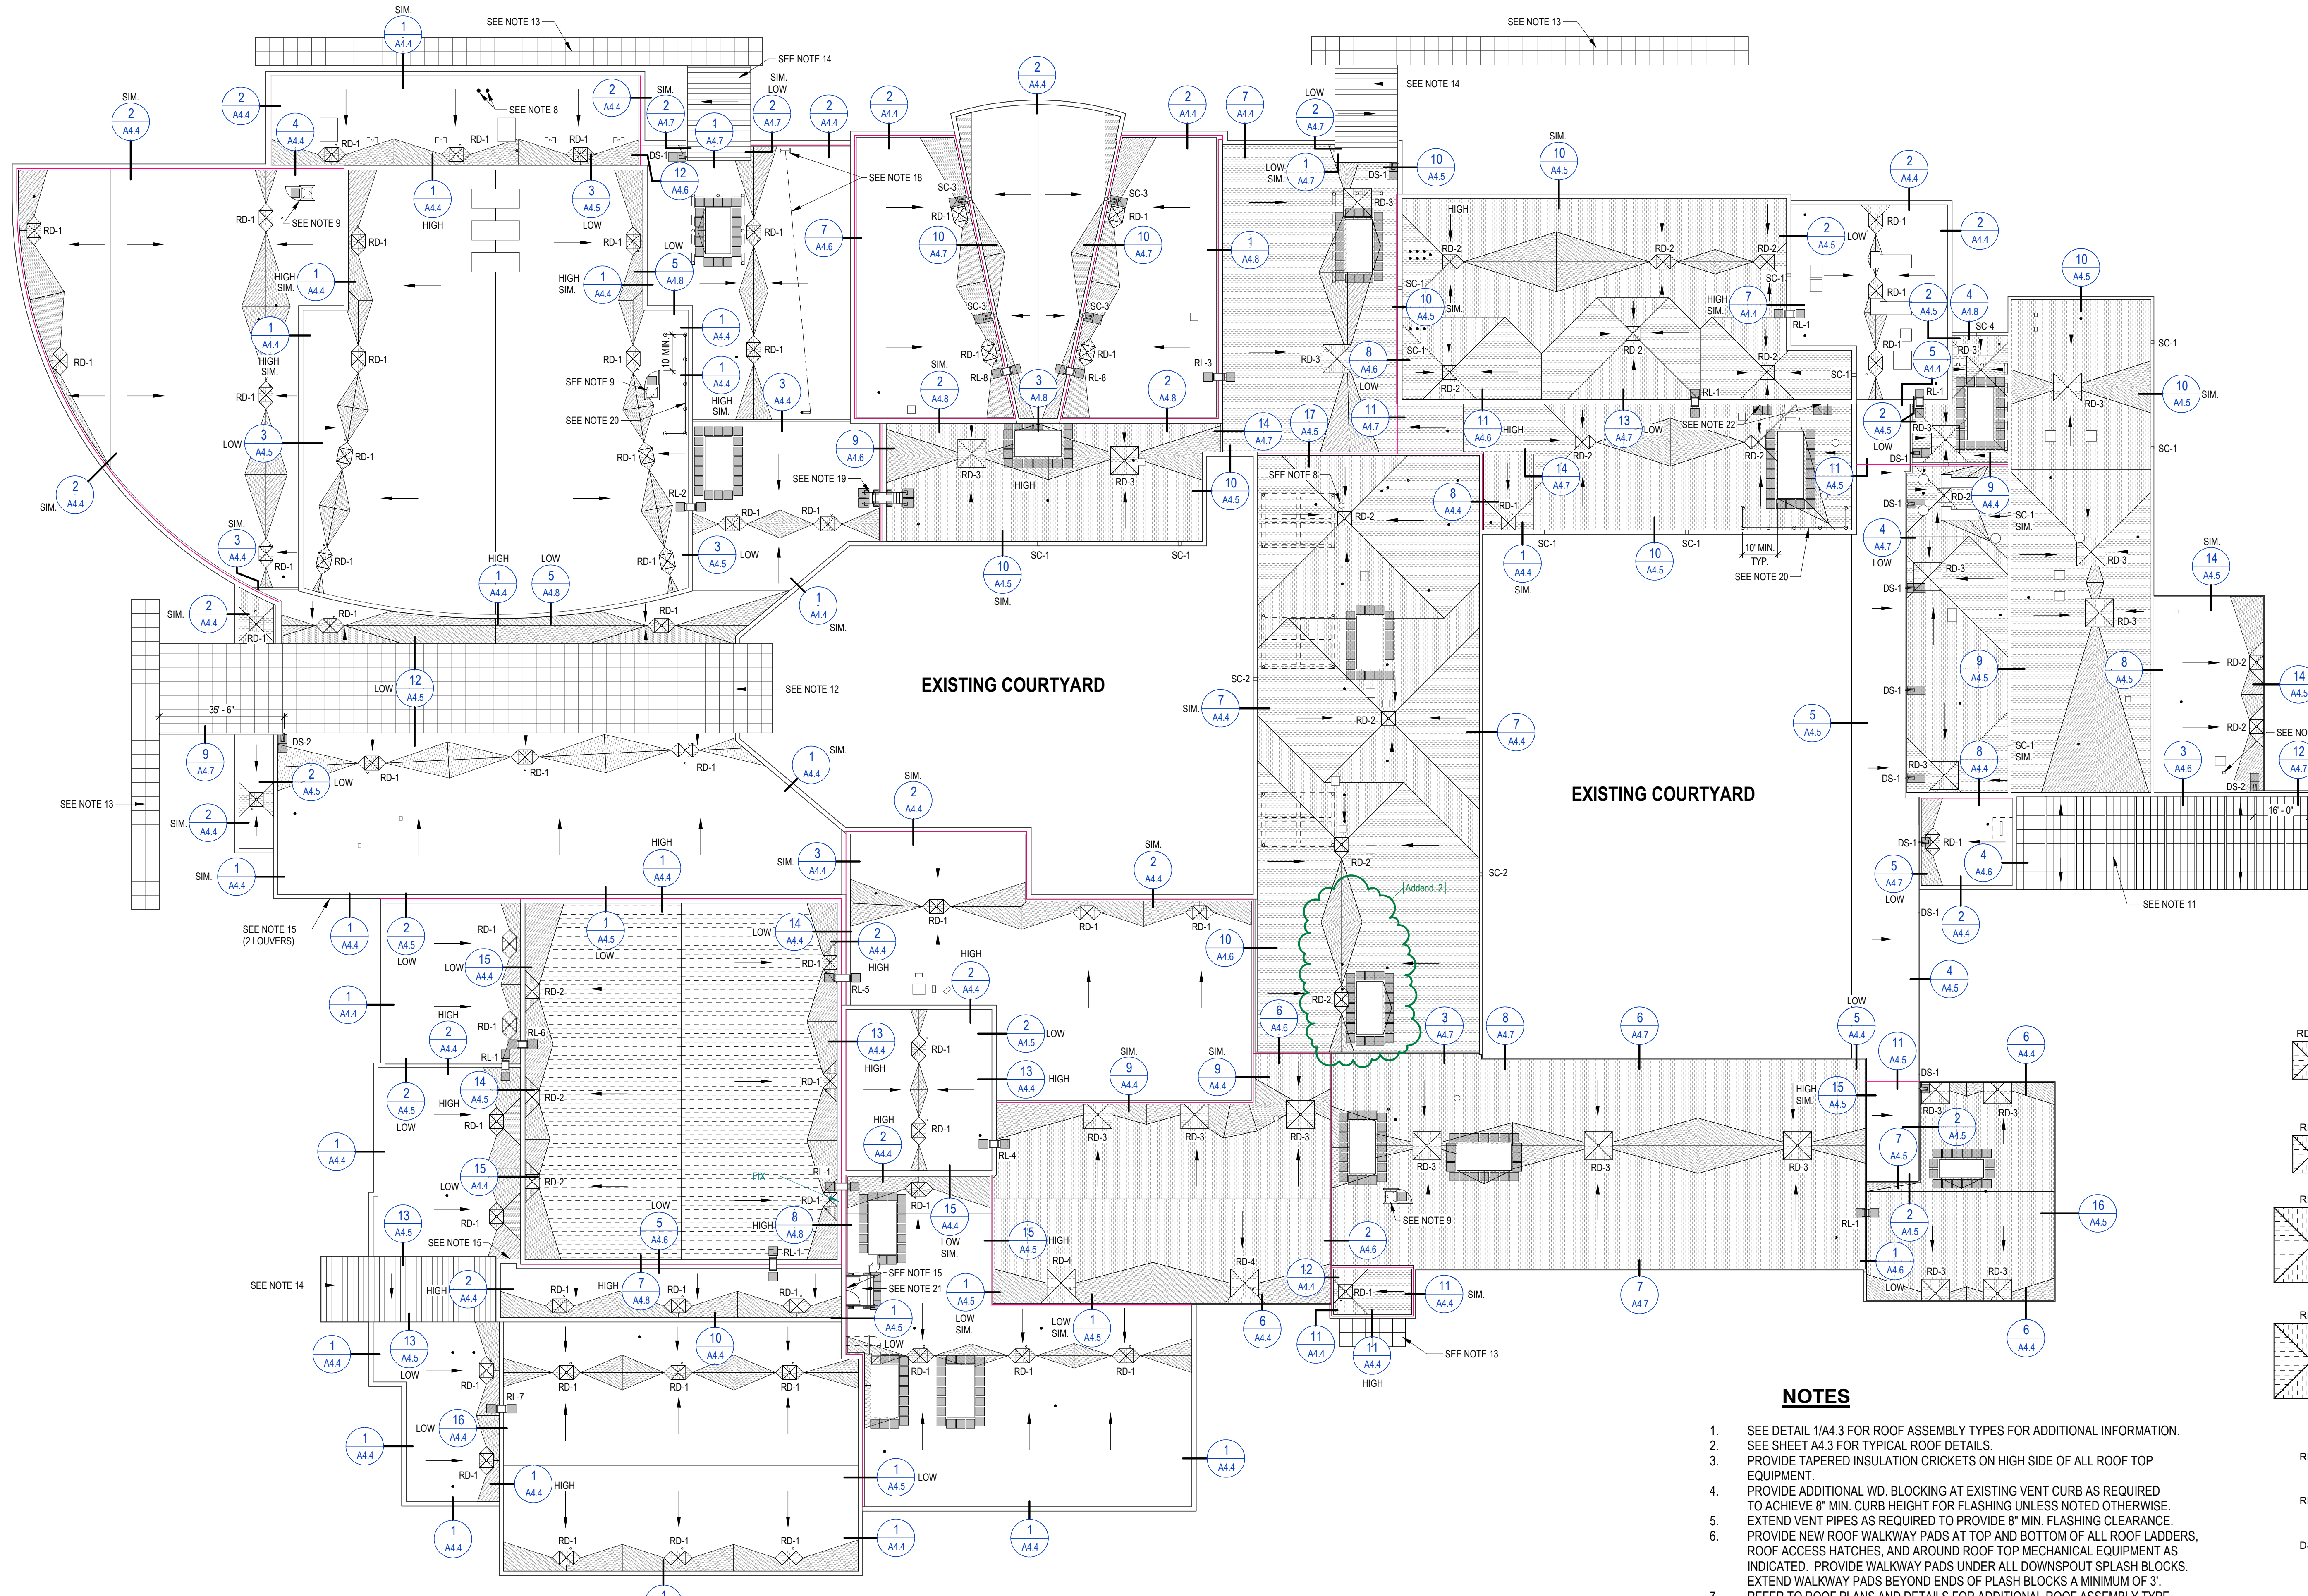


ROOF PLAN LEGEND

- RD-1 EXISTING ROOF DRAIN TO BE REPLACED. PROVIDE 4" x 4" TAPERED INSULATION SUMP (1/2" PER FOOT SLOPE, 2" AT DRAIN) PROVIDE NEW CLAMPING RING AND STRAINER. MODIFY EXISTING OVERFLOW PIPING AS REQUIRED TO INSTALL NEW OVERFLOW DRAIN WITH WATER DAM AND STRAINER. SEE DETAIL 2/A4.3
- OVERFLOW DRAIN. VERIFY SIZES AND LOCATIONS IN FIELD
- RD-2 EXISTING ROOF DRAIN TO BE REPLACED. PROVIDE 4" x 4" TAPERED INSULATION SUMP (1/2" PER FOOT SLOPE, 1/2" AT DRAIN) PROVIDE NEW CLAMPING RING AND STRAINER.
- RD-3 EXISTING ROOF DRAIN TO BE REPLACED. PROVIDE 8" x 8" TAPERED INSULATION SUMP (1/2" PER FOOT SLOPE, 2" AT DRAIN) PROVIDE NEW CLAMPING RING AND STRAINER.
- RD-4 EXISTING ROOF DRAIN TO BE REPLACED. PROVIDE 4" x 4" TAPERED INSULATION SUMP (1/2" PER FOOT SLOPE, 2" AT DRAIN) PROVIDE NEW CLAMPING RING AND STRAINER. MODIFY EXISTING OVERFLOW PIPING AS REQUIRED TO INSTALL NEW OVERFLOW DRAIN WITH WATER DAM AND STRAINER. SEE DETAIL 2/A4.3
- OVERFLOW DRAIN. VERIFY SIZES AND LOCATIONS IN FIELD
- RL-1 EXISTING ROOF LADDER. MODIFY BOTTOMS OF LADDER AS REQUIRED BY NEW ROOF INSULATION THICKNESS. PAINT ALL EXPOSED STEEL SURFACES WITH GALVANIZED PAINT.
- RL-2 THRU 7 NEW ROOF LADDER. SEE DETAILS 1, 2, 3, AND 4/A4.9.
- DS-1 EXISTING DOWNSPOUT. REUSE EXISTING PRECAST CONC. SPLASH BLOCK AT POINT OF DISCHARGE. PROVIDE WALKWAY PADS UNDER SPLASH BLOCK. EXTEND 3" MIN. BEYOND END OF SPLASH BLOCK.
- DS-2 NEW DOWNSPOUT. PROVIDE NEW PRECAST CONC. SPLASH BLOCK AT POINT OF DISCHARGE. PROVIDE WALKWAY PADS UNDER SPLASH BLOCK. EXTEND 7" MIN. BEYOND END OF SPLASH BLOCK.
- SC-X NEW SCUPPER - SEE DETAIL 12/A4.3 FOR SCUPPER TYPE "SC-1". SEE DETAIL 13/A4.3 FOR SCUPPER TYPE "SC-2". SEE DETAIL 15/A4.3 FOR SCUPPER TYPE "SC-4".
- SC-3 NEW SCUPPER WITH CONDUCTOR HEAD AND DOWNSPOUT. PROVIDE NEW SPLASH BLOCK. PROVIDE WALKWAY PADS UNDER SPLASH BLOCK AND EXTEND PADS BEYOND END OF SPLASH BLOCK A MIN. OF 3". SEE DETAIL 16/A4.3.
- WALKWAY PAD
- ROOF ASSEMBLY TYPE "1" (NEW 1/4" PER FOOT TAPERED INSULATION ON LEVEL STRUCTURE)
- ROOF ASSEMBLY TYPE "2" (NEW INSULATION ON EXISTING 1/4" PER FOOT SLOPED STRUCTURE)
- ROOF ASSEMBLY TYPE "3" (NEW 1/8" PER FOOT TAPERED INSULATION ON EXISTING 1/8" PER FOOT SLOPED STRUCTURE)
- TAPERED INSULATION CRICKET - 1/2" PER FOOT MINIMUM UNLESS NOTED OTHERWISE - SLOPE TO ROOF DRAINS. HATCH PATTERN INDICATED SLOPE DIRECTION.
- INDICATES POSITIVE ROOF SLOPE

NOTES

1. SEE DETAIL 1/A4.3 FOR ROOF ASSEMBLY TYPES FOR ADDITIONAL INFORMATION.
2. SEE SHEET A4.3 FOR TYPICAL ROOF DETAIL.
3. PROVIDE TAPERED INSULATION CRICKETS ON HIGH SIDE OF ALL ROOF TOP EQUIPMENT.
4. PROVIDE ADDITIONAL WD. BLOCKING AT EXISTING VENT CURB AS REQUIRED TO ACHIEVE 8" MIN. CURB HEIGHT FOR FLASHING UNLESS NOTED OTHERWISE.
5. EXTEND VENT PIPES AS REQUIRED TO PROVIDE 8" MIN. FLASHING CLEARANCE. PROVIDE NEW ROOF WALKWAY PADS AT TOP AND BOTTOM OF ALL ROOF LADDERS, ROOF ACCESS HATCHES, AND AROUND ROOF TOP MECHANICAL EQUIPMENT AS INDICATED. PROVIDE WALKWAY PADS UNDER ALL DOWNSPOUT SPLASH BLOCKS. EXTEND WALKWAY PADS BEYOND ENDS OF SPLASH BLOCKS A MINIMUM OF 3". REFER TO ROOF PLANS AND DETAILS FOR ADDITIONAL ROOF ASSEMBLY TYPE LOCATIONS.
6. EXISTING HOT STACK - SEE DETAIL 8/A4.3.
7. NEW ROOF ACCESS HATCH WITH GUARDRAILS AND GATE. SEE DETAILS 16 AND 17/A4.3.
8. INSTALL FALL PROTECTION GUARDRAILS AS SPECIFIED.
9. EXISTING GREENHOUSE GLAZED ROOF SYSTEM. CLEAN AND REMOVE EXISTING SEALANT AROUND PERIMETER OF EACH GLASS PANEL AND INSTALL NEW EXISTING GLAZED SLOPED ROOF SYSTEM. CLEAN AND REMOVE EXISTING SEALANT AROUND PERIMETER OF EACH GLASS PANEL AND INSTALL NEW EXISTING GLAZED SLOPED CANOPY TO REMAIN.
10. EXISTING STANDING SEAM METAL ROOFING TO REMAIN.
11. REMOVE EXISTING SEALANT AROUND PERIMETER OF EXISTING MECHANICAL LOUVER. INSTALL NEW BACKER ROD AND SEALANT. MATCH EXISTING LOUVER COLOR.
12. REFER TO DETAIL 9/A4.3 FOR TYPICAL PIPE PENETRATION DETAIL.
13. REINSTALL EXISTING WEATHER STATION AT THIS LOCATION. EXTEND WIRING AND CONDUIT FROM JUNCTION BOX TO NEW LOCATION.
14. MOVE EXISTING WEATHER STATION AND CABLE AS REQUIRED TO INSTALL NEW ROOFING SYSTEM. RELOCATE BACK TO ITS ORIGINAL POSITION UPON COMPLETION OF NEW ROOF WORK. PROTECT EQUIPMENT AS REQUIRED DURING CONSTRUCTION.
15. NEW ROOF STAIR. SEE DETAILS 5 & 6/A4.9.
16. INSTALL NEW FALL PROTECTION RAILINGS AS SPECIFIED.
17. INSTALL NEW ROOF ACCESS STAIR. SEE DETAILS 7 & 8/A4.9.
18. SEE DETAIL 9/A4.8 FOR FLASHING DETAIL AT EXISTING DOOR SILL.
19. REFER TO STRUCTURAL, MECHANICAL AND ELECTRICAL DRAWINGS FOR ALTERNATE 1 INFORMATION.
20. ALL ALUMINUM COPINGS AND EDGE METAL SHALL BE MILL FINISH, U.N.O.
21. ALL METAL FLASHING SHALL BE STAINLESS STEEL, U.N.O.
22. CLEAN AND PREP ALL EXISTING WALL AND CURB SURFACES AS REQUIRED TO RECEIVE NEW ROOF SYSTEM MATERIALS.

OVERALL ROOF PLAN

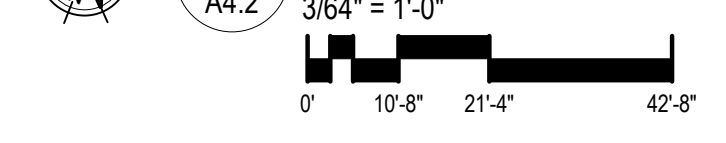

ROOF DECK TYPE KEY PLAN

1" = 100'-0"



PCS NO. L12F016

DRAWING NOTES


- ① RX PRIMARY ROOF DRAIN.
- ② DISCONNECT DUCTS, PIPING, AND CONTROLS FROM UNITS. EX CURBS WILL REMAIN.
- ③ RX SECONDARY ROOF DRAIN.

GENERAL NOTES


- 1. EX INDICATED IN THIN/LIGHT LINE WEIGHT
- 2. DEMOLITION WORK INDICATED IN THICK/DARK LINE WEIGHT

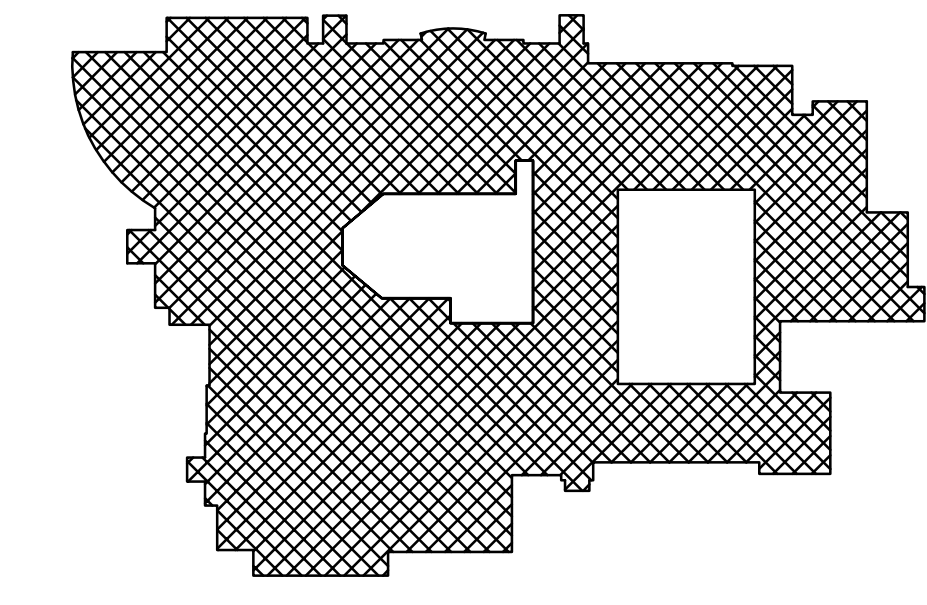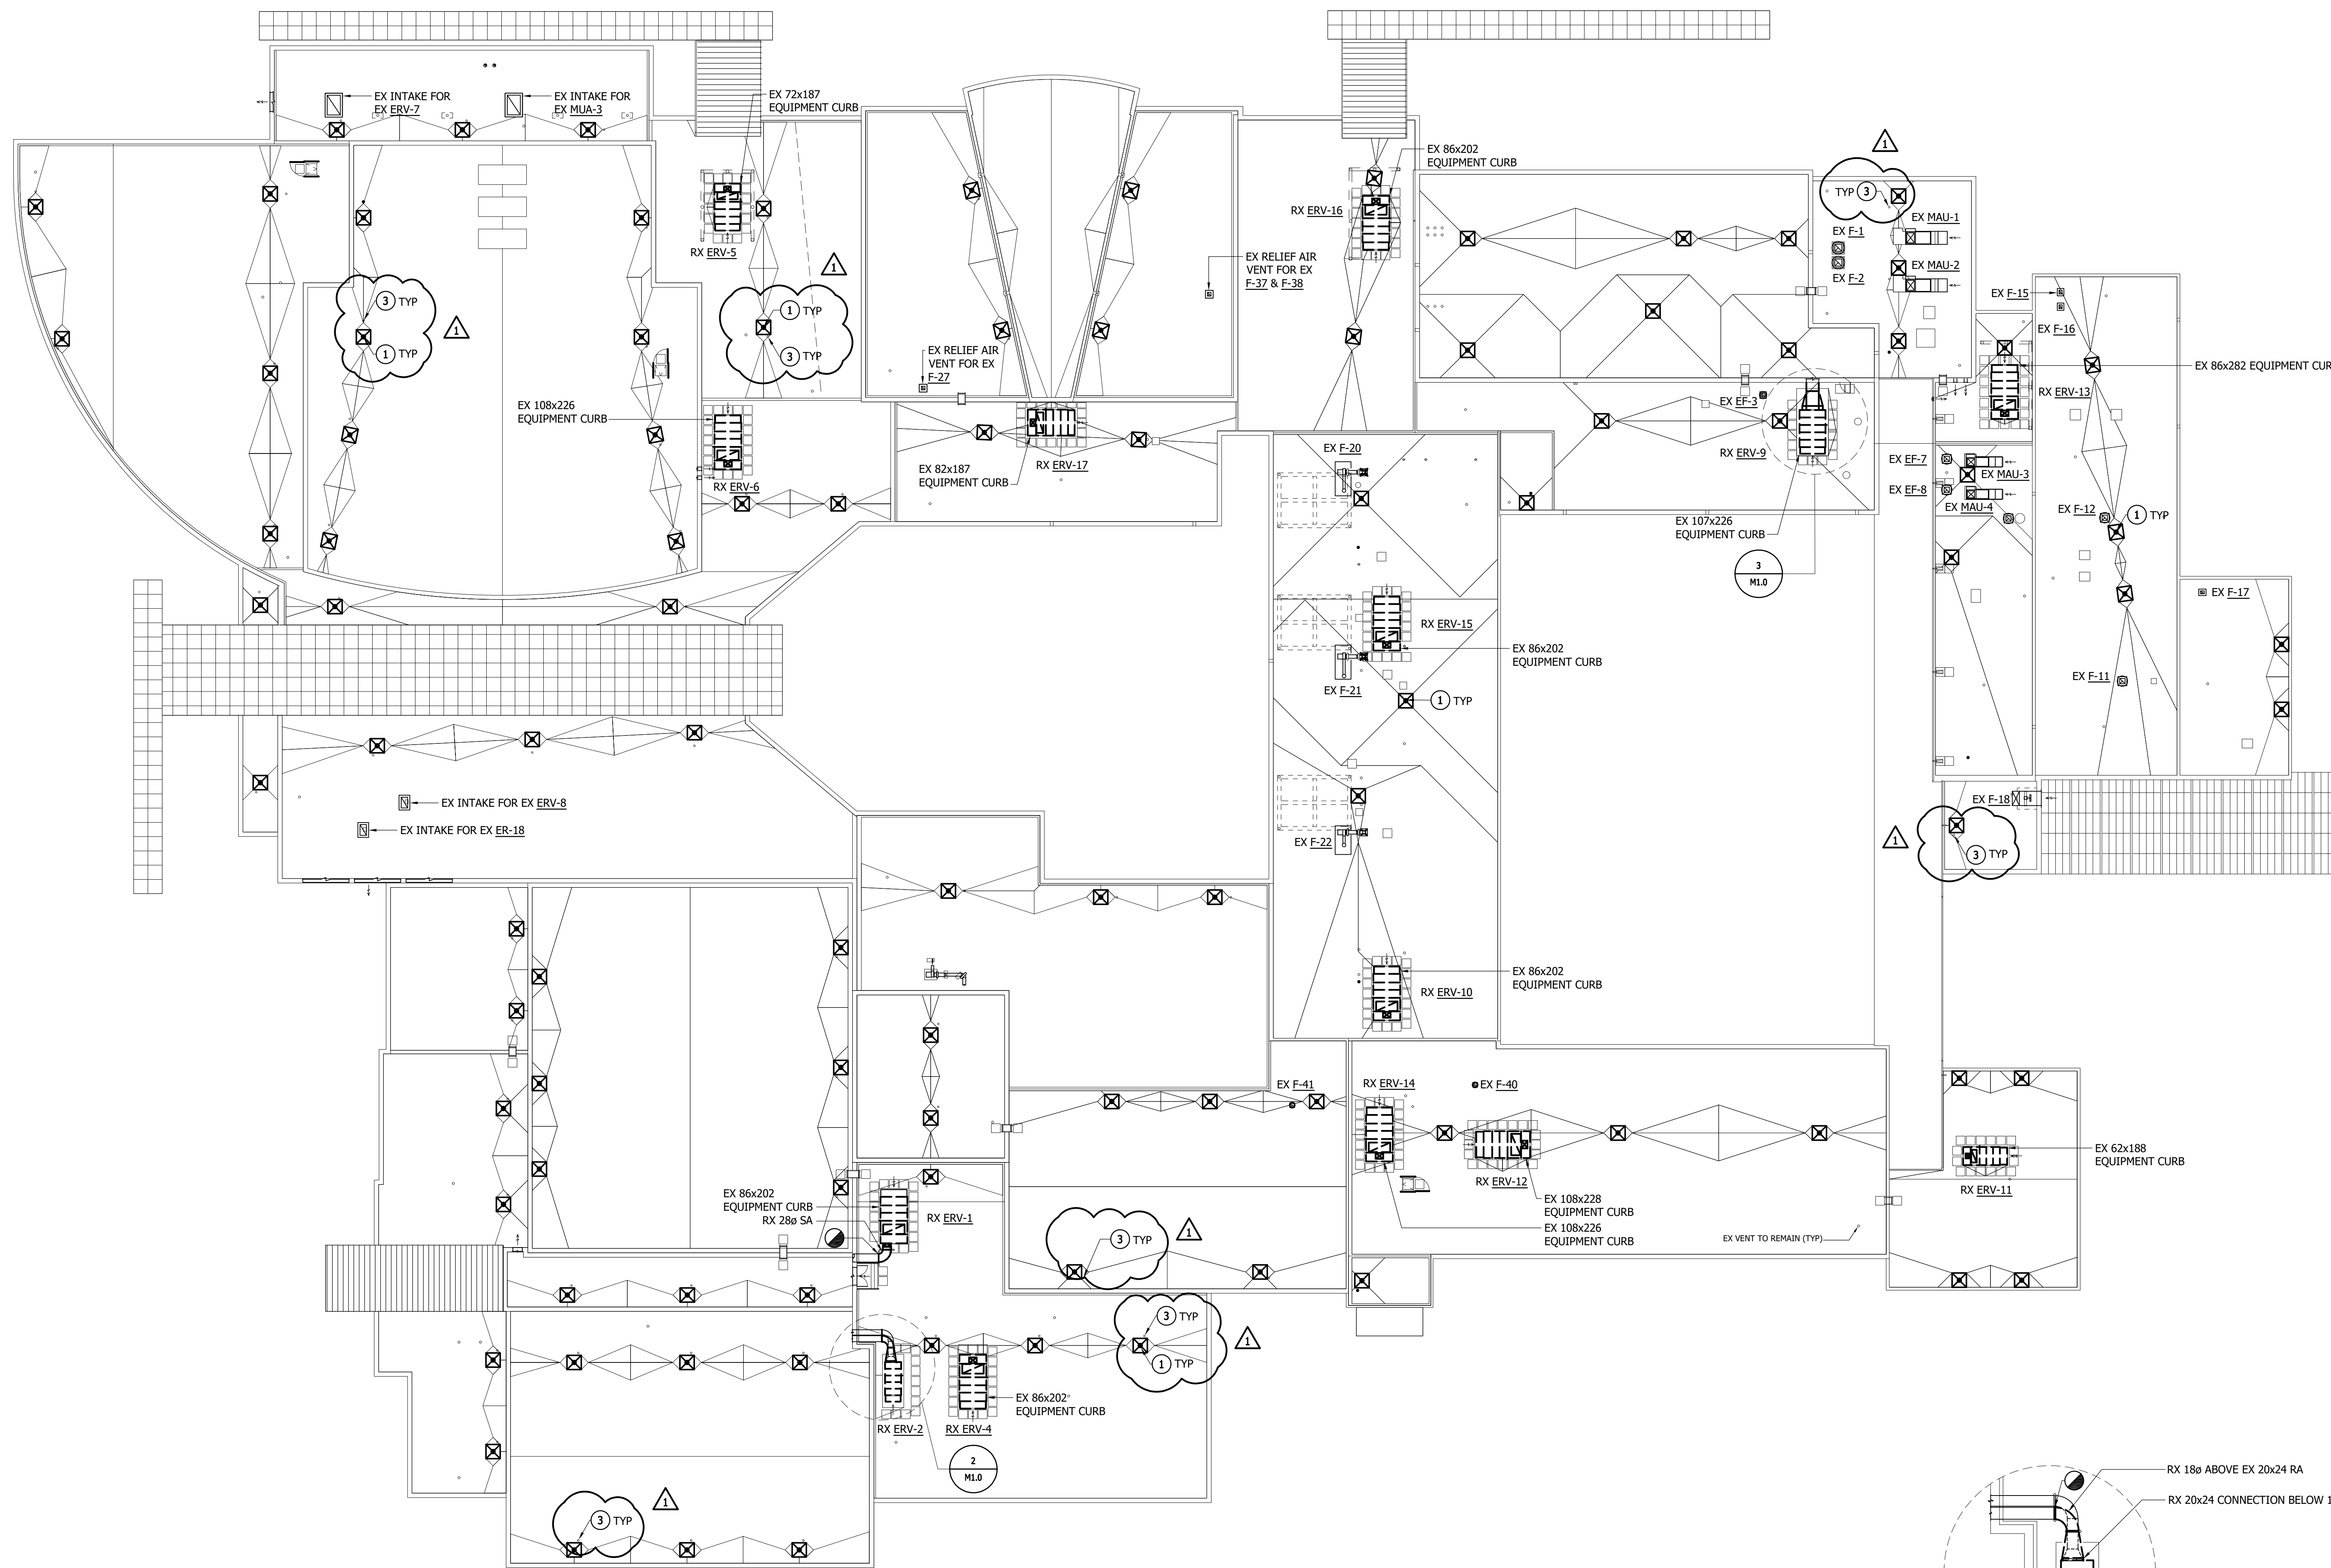

③ M1.0 ENLARGED PART-PLAN - DEMOLITION
SCALE: 3/32" = 1'-0"

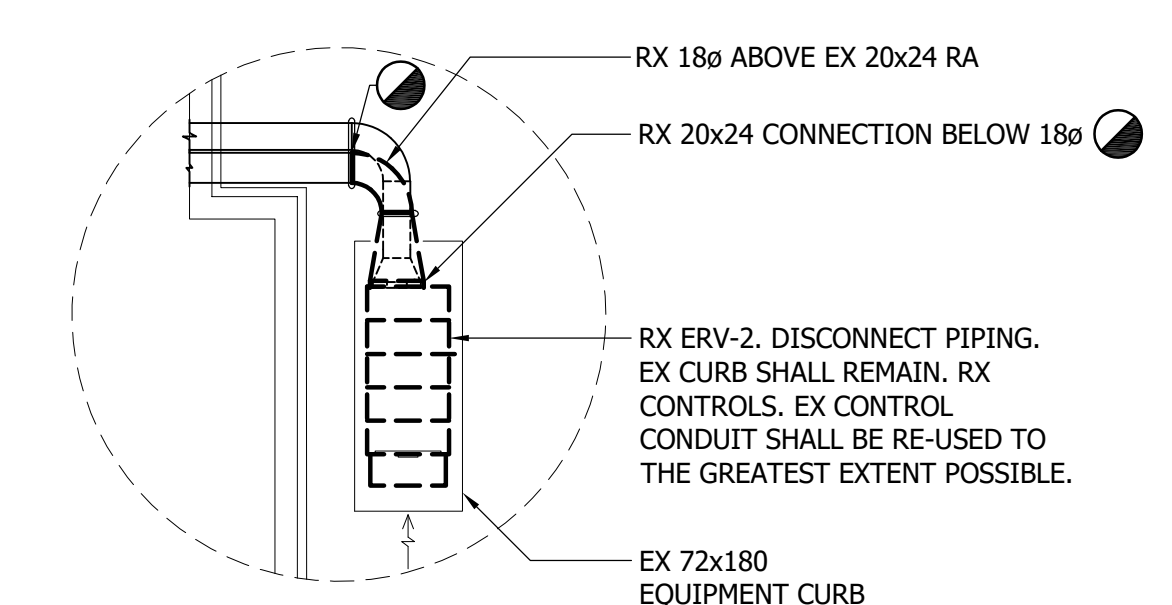

② M1.0 ENLARGED PART-PLAN - DEMOLITION
SCALE: 3/32" = 1'-0"

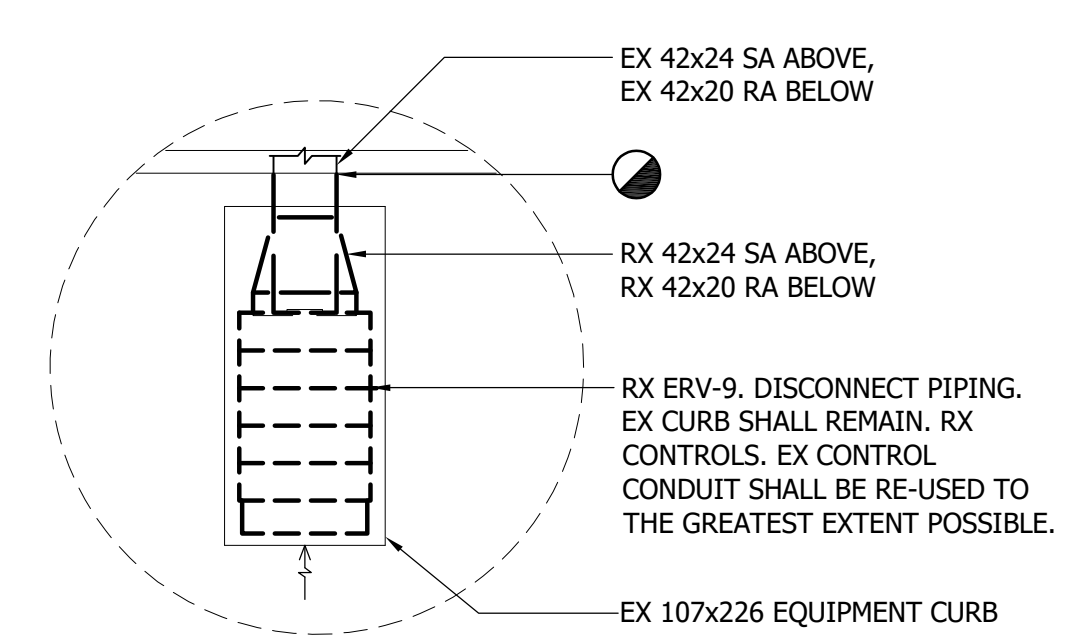

① M1.0 OVERALL ROOF PLAN - DEMOLITION
SCALE: 3/64" = 1'-0"

Gilbert Architects retains all ownership, copyright, and other intellectual property rights in the data and information on these plans. The receiver warrants that the data and information on these plans shall not be used for any other purpose without the permission of Gilbert Architects.

Gipe Associates, Inc.
 CONSULTING ENGINEERS
 www.gipe.net
 1000 North Chanters Street
 P.O. Box 100
 Pikesville, MD 21076
 Telephone: 410.822.2400
 Fax: 410.822.2408
 W.O.P.# 25097

PROFESSIONAL CERTIFICATION:
 THESE DOCUMENTS WERE PREPARED OR APPROVED BY A LICENSED PROFESSIONAL ENGINEER UNDER THE LAWS OF MARYLAND.
 EXPIRATION DATE: 12/31/2024

608 North Chanters Street
 Pikesville, MD 21076
 P: 410.822.2400
 F: 410.822.2408
 200 Continental Drive, Suite 401
 Newark, DE 19713
 F: 302.261.6106
 04851 Fairview Circle, Suite 400
 Pikesville, MD 21076
 P: 410.386.8866

GILBERT
 ARCHITECTS



OVERALL ROOF PLAN - DEMOLITION
ROOF REPLACEMENT:
NORTH HARFORD HIGH SCHOOL
HARFORD COUNTY PUBLIC SCHOOLS
PYLESVILLE, MARYLAND 21132

REVISION	DATE
1 ADDENDUM NO. 2	04/09/2020


DRAWN BY: C.J.W.
 PROJECT NO.: 25097
 SHEET NO.: **M1.0**
 DATE: 03/15/2020

GENERAL NOTES

- EX INDICATED IN THIN/LIGHT LINE WEIGHT.
- DEMOLITION WORK IS INDICATED IN THICKER/DARK LINE WEIGHT

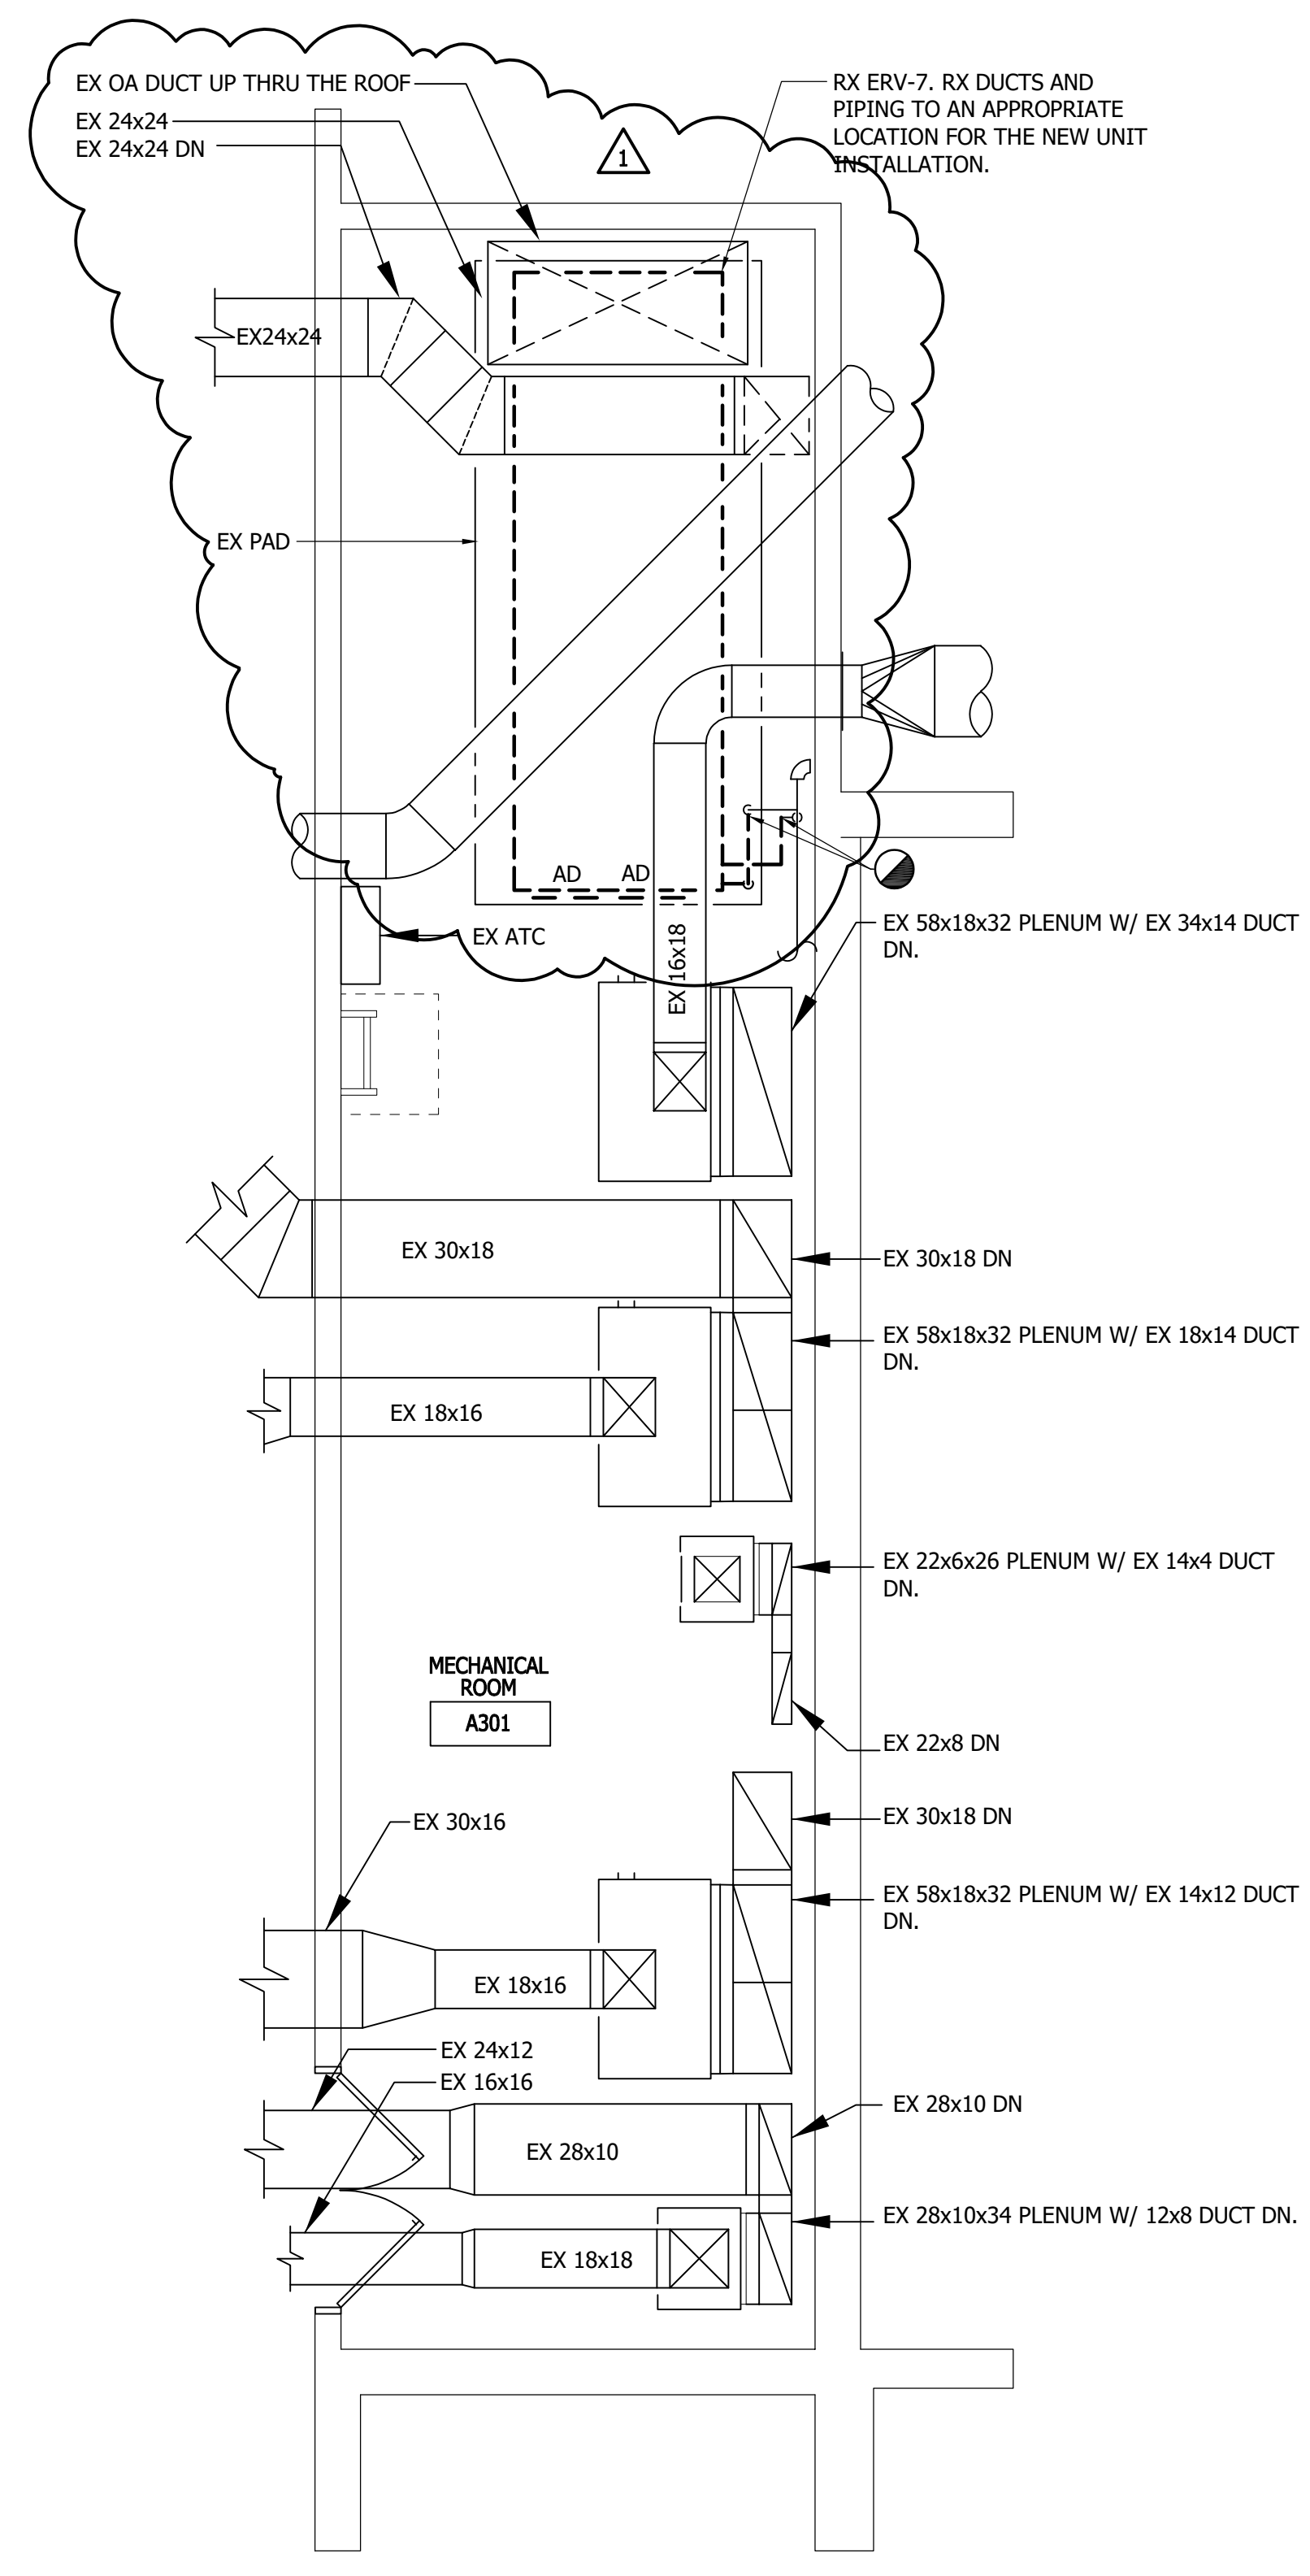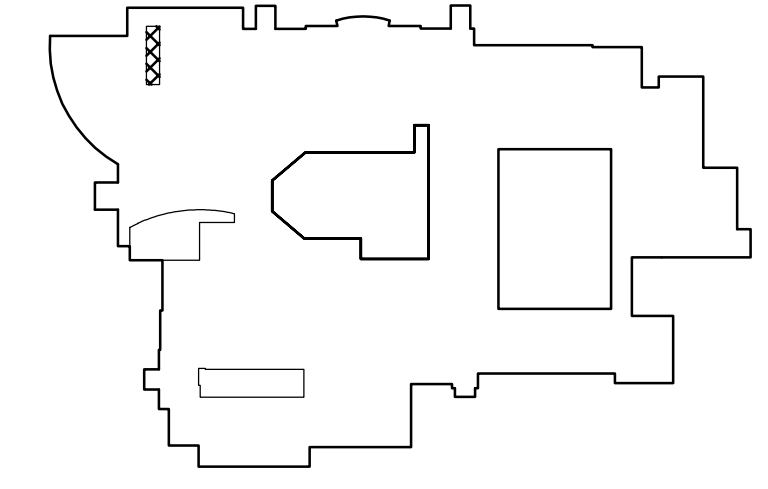


MECHANICAL ROOM A301 - DEMOLITION
SCALE: 1/4" = 1'-0"

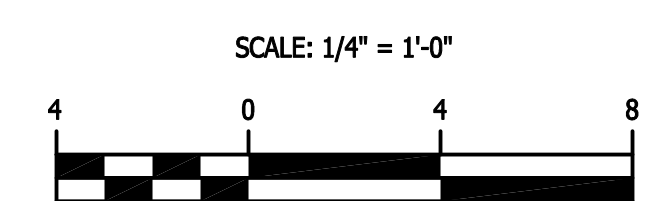


Gilbert Architects retains all rights in the design and information on these drawings. No part of these drawings shall be reproduced, distributed, or otherwise made use of the data or drawings without the permission of Gilbert Architects.

Gilbert Associates, Inc.
CONSULTING ENGINEERS
www.gac.net
1220 East 20th Street, Suite 223
Baltimore, Maryland 21208
410.532.2400
410.532.8888
W.C. # 25097
PROFESSIONAL ENGINEER LICENSE NO. 145202
REGISTERED TO GILBERT ASSOCIATES, INC. AS A PROFESSIONAL ENGINEER OF CIVIL ENGINEERING IN THE STATE OF MARYLAND
ASSOCIATES, INC. July 19th 1988

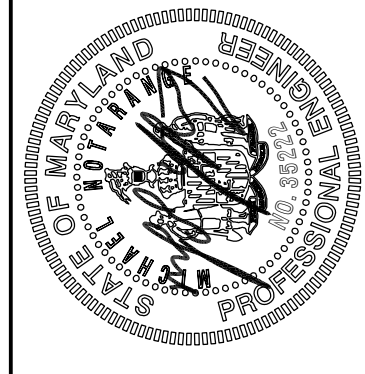

PROFESSIONAL CERTIFICATION: THESE DOCUMENTS WERE PREPARED BY ME AND I AM A FULLY LICENSED PROFESSIONAL ENGINEER OF THE STATE OF MARYLAND. LICENSE NO. 145202, EXPIRES 01/05/2028.

638 North Chesapeake Street
Lanham, PA 17603
P: 717.291.1077
200 Continental Drive, Suite 401
P: 302.318.1900
14651 Lakeside Circle, Suite 400
Columbia, MD 21117
P: 410.358.8888

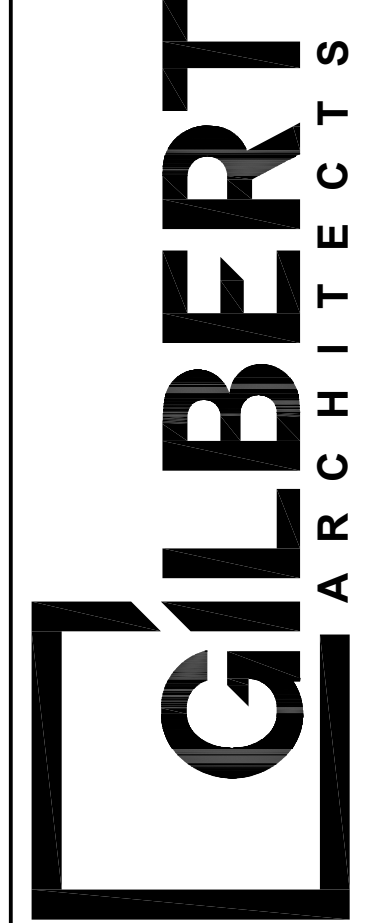

MECHANICAL ROOM A301 - DEMOLITION
ROOF REPLACEMENT:
NORTH HARFORD HIGH SCHOOL
HARFORD COUNTY PUBLIC SCHOOLS
PYLESVILLE, MARYLAND 21132

REVISION	DATE
1 - ADDENDUM NO. 2	04/08/2020

DRAWN BY: C.J.W.
PROJECT NO.: 25097
SHEET NO.: **M1.1**
DATE: 03/15/2020




DRAWING NOTES

- 1. INSTALL PRIMARY ROOF DRAIN. PROVIDE ANY PIPE MODIFICATIONS REQUIRED TO CONNECT ROOF DRAIN OUTLET TO EXISTING STORM WATER PIPING. SEE ARCHITECTURAL DETAILS FOR ADDITIONAL INFORMATION.
- 2. INSTALL SECONDARY ROOF DRAIN. PROVIDE ANY PIPE MODIFICATIONS REQUIRED TO CONNECT ROOF DRAIN OUTLET TO EXISTING STORM WATER PIPING. SEE ARCHITECTURAL DETAILS FOR ADDITIONAL INFORMATION.




GENERAL NOTES

- 1. EX INDICATED IN THIN/LIGHT LINE WEIGHT
- 2. NEW WORK INDICATED IN THICK/DARK LINE WEIGHT
- 3. INSTALL NEW ERV AND ASSOCIATED AND ROOF CURB ADAPTER ON EXISTING ROOF EQUIPMENT CURB. EXTEND AND RECONNECT ALL SERVICES. EXTEND GEOTHERMAL HEAT PUMP PIPING AND MAKE CONNECTION TO NEW ERV.
- 4. NEW CONDENSATE PIPING SHALL BE PROVIDED FROM CONNECTION OF UNIT AND SLOPED TO NEAREST ROOF DRAIN. THE DESIGN OF THE NEW CONDENSATE PIPING SHALL BE IN ACCORDANCE WITH THE MANUFACTURER'S RECOMMENDATIONS. FOR ALL CONDENSATE PIPING, PROVIDE AN ADJUSTABLE HEIGHT SINGLE PIPE ROLLER ROOF SUPPORT SUITABLE FOR MEMBRANE ROOF SYSTEMS. PIPE SUPPORT SHALL BE POLYCARBONATE WITH STAINLESS STEEL ALL-THREAD RODS AND HOT-DIP GALVANIZED HARDWARE.
- 5. EXISTING FANS ARE EXISTING TO REMAIN. PROVIDE FLASHING FOR DUCT PENETRATIONS OR CURBS THAT LACK SUFFICIENT FLASHING.
- 6. EXTEND ALL EXISTING PLUMBING VENTS TO REMAIN TO A MINIMUM OF 8" ABOVE NEWLY FINISHED ROOF PLANE AND INSTALL NEW FLASHING IN ACCORDANCE WITH ARCHITECTURAL DRAWINGS

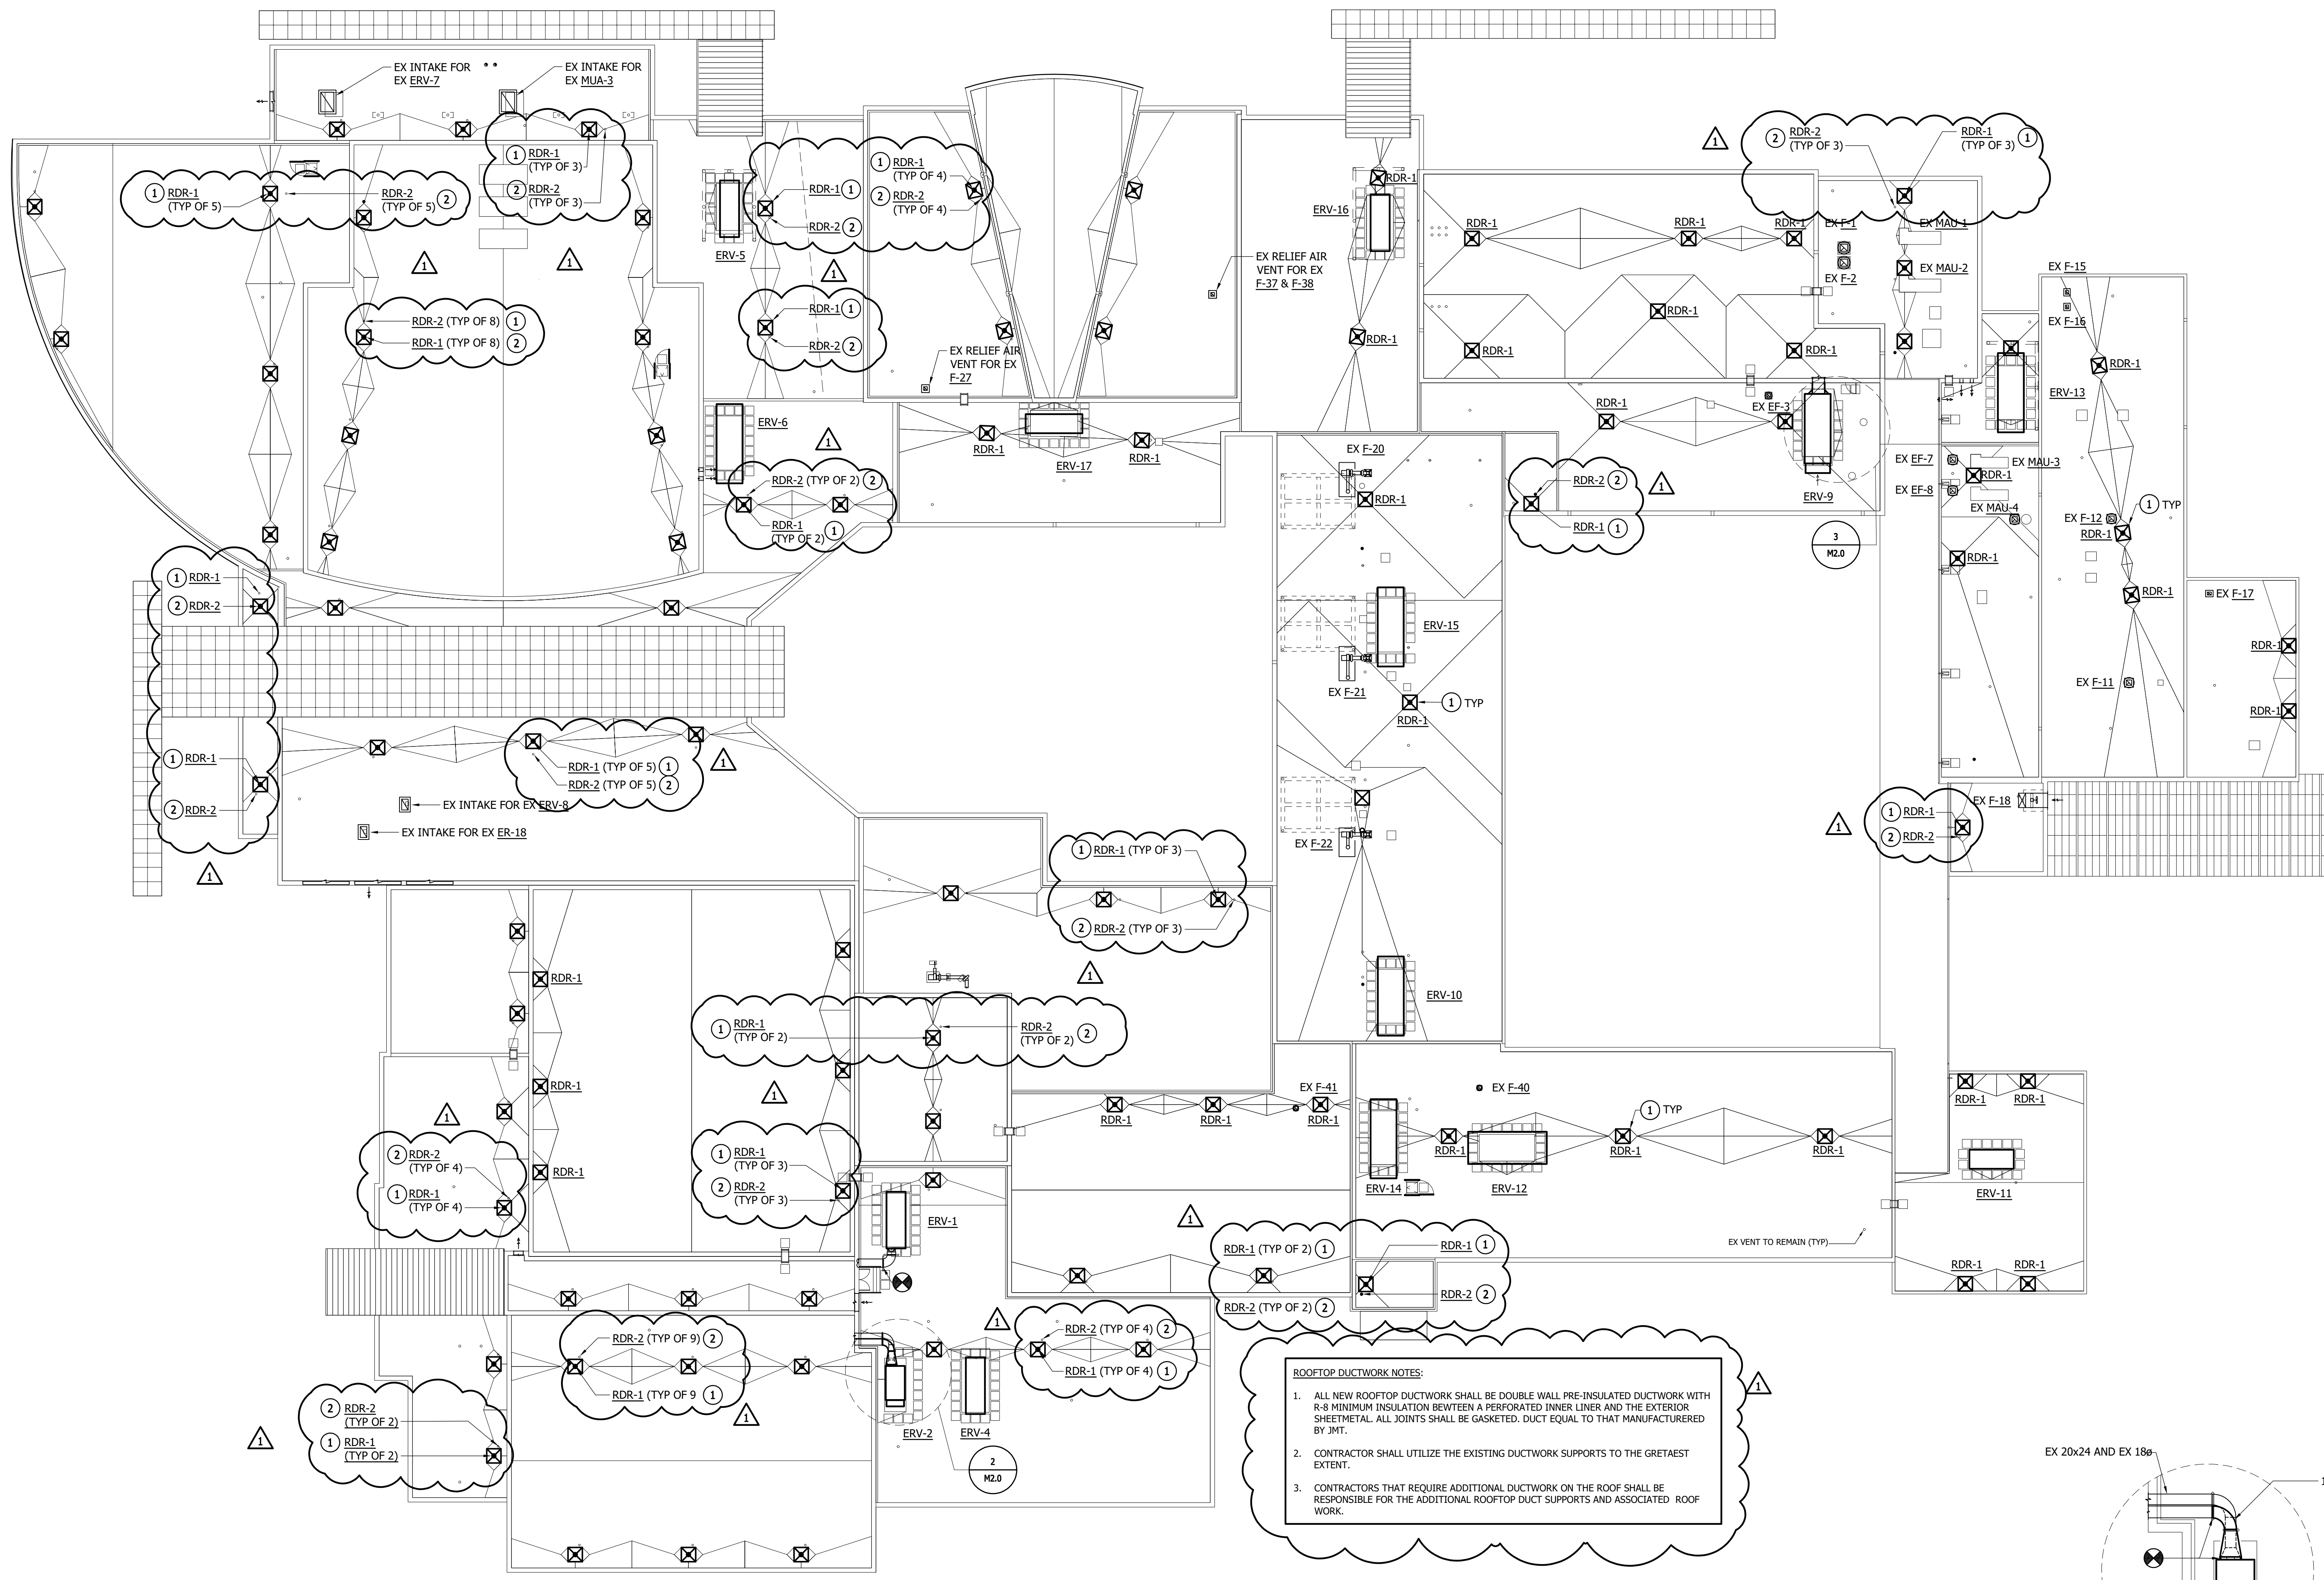

ROOFTOP DUCTWORK NOTES:



1. ALL NEW ROOFTOP DUCTWORK SHALL BE DOUBLE WALL PRE-INSULATED DUCTWORK WITH R-8 MINIMUM INSULATION BETWEEN A PERFORATED INNER LINER AND THE EXTERIOR SHEETMETAL. ALL JOINTS SHALL BE GASKETED. DUCT EQUAL TO THAT MANUFACTURED BY JMT.
2. CONTRACTOR SHALL UTILIZE THE EXISTING DUCTWORK SUPPORTS TO THE GREATEST EXTENT.
3. CONTRACTORS THAT REQUIRE ADDITIONAL DUCTWORK ON THE ROOF SHALL BE RESPONSIBLE FOR THE ADDITIONAL ROOFTOP DUCT SUPPORTS AND ASSOCIATED ROOF WORK.

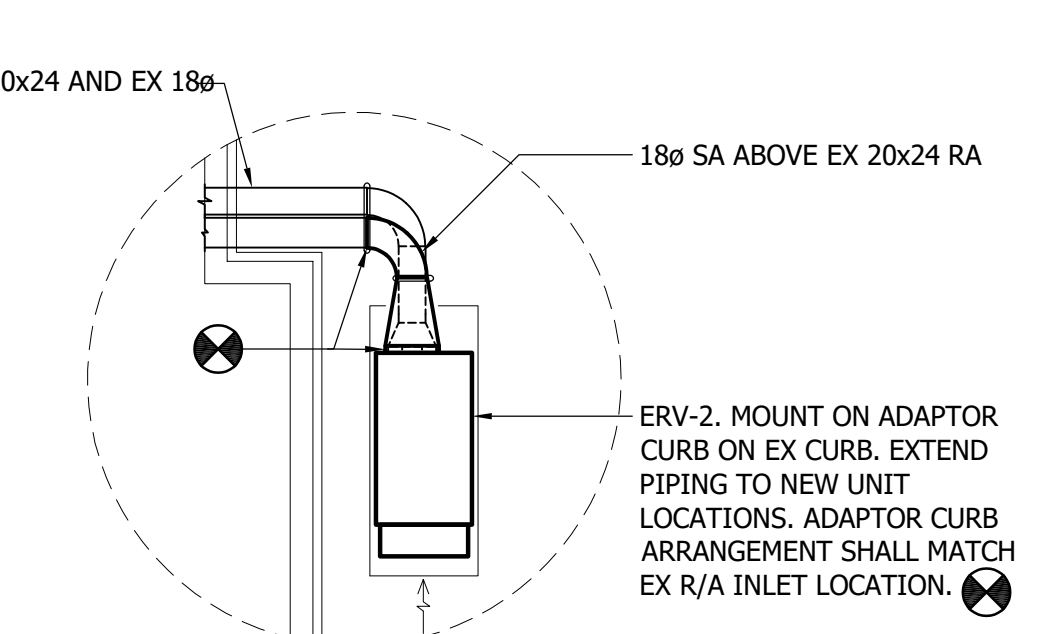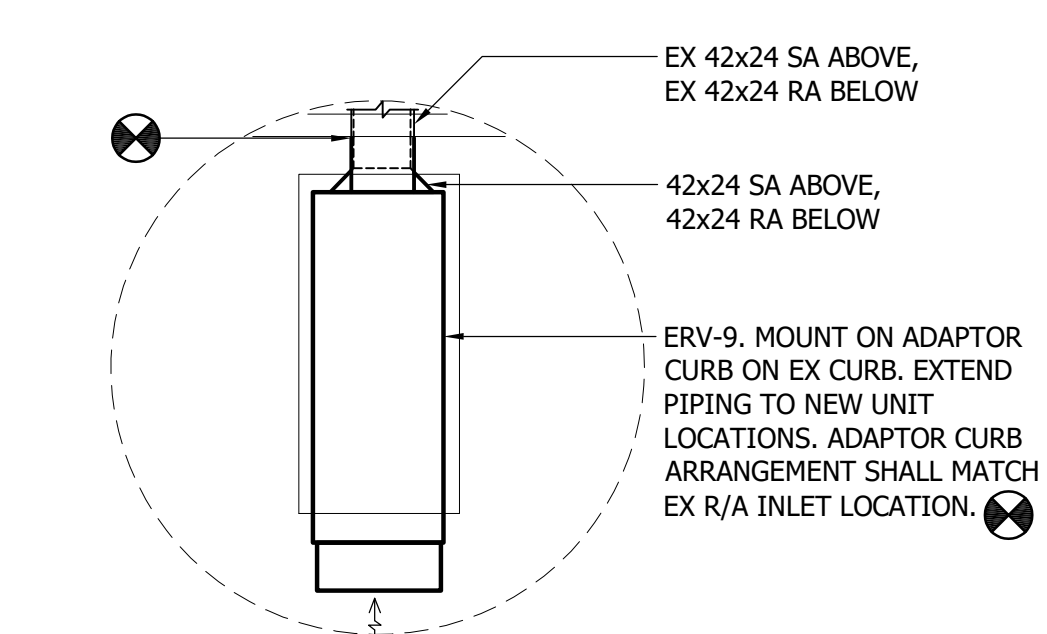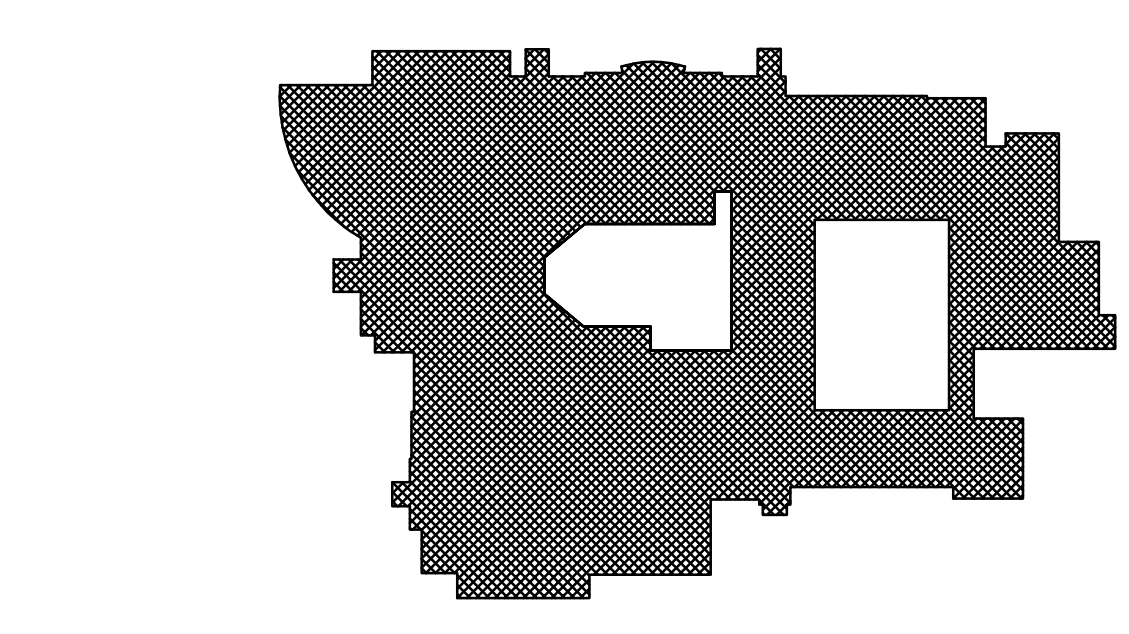

1
M2.0
OVERALL ROOF PLAN - NEW WORK
SCALE: 3/64" = 1'-0"


2
M2.0
ENLARGED PART-PLAN - NEW WORK
SCALE: 3/32" = 1'-0"

3
M2.0
ENLARGED PART-PLAN - NEW WORK
SCALE: 3/32" = 1'-0"

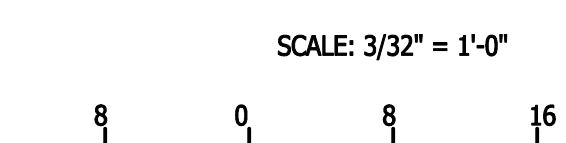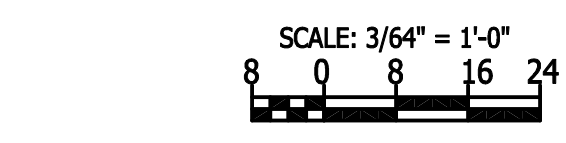

Client Architect retains all intellectual property interests in the data and information on these drawings. The information on these drawings is to be used only for the project and site identified herein. It is not to be reproduced, distributed, or otherwise made use of the data or information without the permission of Gilbert Architects.

Gilbert Associates, Inc.
CONSULTING ENGINEERS
www.gilbert.com
1220 East 20th Street, Suite 223
Annapolis, Maryland 21403
P: 410.832.8200
F: 410.832.8888
W.C.P. # 25097

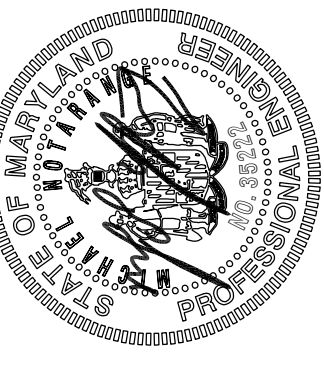

PROFESSIONAL CERTIFICATION: THESE DOCUMENTS WERE PREPARED BY ME AND I AM A DULY LICENSED PROFESSIONAL ENGINEER IN THE STATE OF MARYLAND. LICENSE NO. 25097. EXPIRES: 01/05/2028.

630 North Chesapeake Street
Lancaster, PA 17603
P: 717.291.1077
300 Continental Drive, Suite 401
Pylesville, MD 21151
P: 302.318.1300
10455 Lakeside Circle, Suite 400
Chesapeake, MD 21717
P: 410.558.8888



OVERALL ROOF PLAN - NEW WORK
ROOF REPLACEMENT:
NORTH HARFORD HIGH SCHOOL
HARFORD COUNTY PUBLIC SCHOOLS
PYLESVILLE, MARYLAND 21132

REVISION	DATE
1 ADDENDUM NO. 2	04/08/2020

DRAWN BY: CJW
PROJECT NO: 25097
SHEET NO:

M2.0


DATE: 03/15/2020

PCS NO. L12F016

			<p>NOTES:</p> <p>1. EX UNIT CURB DIMENSIONS ARE INDICATED ON THE DRAWINGS. EX ROOF CURBS SHALL REMAIN. NEW UNITS SHALL UTILIZE CURB ADAPTERS TO ARRANGE THE AIR FLOWS BELOW THE UNITS TO MATCH EXISTING DUCT CONNECTIONS. EXTEND ALL PIPING WITHIN THE EXISTING CURB TO THE NEW LOCATIONS WITHIN THE NEW UNITS.</p> <p>COMPONENTS:</p> <p>1. THE NEW UNITS SHALL BE WATER COOLED, EXTENDED RANGE GEOTHERMAL HEAT PUMP UNITS WITH FACTORY TERMINAL STRIPS FOR CONTROLS BY JOHNSON CONTROLS, INCORPORATED. UNITS SHALL HAVE THEIR ASSOCIATED HARDWIRED SAFETIES. REFER TO SPECIFICATIONS, SCHEDULES AND AUTOMATIC CONTROLS FOR ADDITIONAL INFORMATION.</p> <p>ADDITIONAL OUTSIDE AIR SIDE COMPONENTS SHALL INCLUDE:</p> <ol style="list-style-type: none"> 1. OUTSIDE AIR INTAKE PLENUM WITH ASSOCIATED HOODS AND DAMPERS. 2. OUTSIDE AIR 2" MERV 8 FILTERS UPSTREAM OF THE TOTAL ENERGY WHEEL. 3. TOTAL ENERGY WHEEL WITH BYPASSES. 4. 4" MERV 13 FINAL FILTER. 5. REFRIGERATION COIL AND ASSOCIATED CIRCUITS AND COMPRESSORS, ETC. 6. HOT GAS REHEAT COIL 7. OUTSIDE AIR SUPPLY FAN. <p>ADDITIONAL RETURN/EXHAUST AIR SIDE COMPONENTS SHALL INCLUDE:</p> <ol style="list-style-type: none"> 1. RA DAMPER. 2. 2" MERV 8 FILTERS UPSTREAM OF THE TOTAL ENERGY WHEEL. 3. EXHAUST AIR FAN. 4. EXHAUST AIR PLENUM WITH ASSOCIATED HOODS AND DAMPERS. <p>BASIS OF DESIGN UNIT SIZES:</p> <ol style="list-style-type: none"> 1. THE UNIT SIZES ARE THE TOTAL CABINET SIZE WITH ALL EQUIPMENT ENCLOSED AND IS THE SIZE OF THE UNIT SUPPORT FRAME. SIZE DOESN'T INCLUDE THE HOOD DIMENSIONS THAT DO NOT IMPACT THE CURB SIZE. 2. ERV-4: 135"L x 64"W x 66"H; EX CURB SIZE: 102"L x 86"W 3. ERV-5: 135"L x 64"W x 66"H; EX CURB SIZE: 187"L x 72"W 4. ERV-6: 200"L x 87"W x 86"H; EX CURB SIZE: 226"L x 108"W 5. ERV-10: 200"L x 87"W x 86"H; EX CURB SIZE: 202"L x 86"W 6. ERV-11: 114"L x 64"W x 62"H; EX CURB SIZE: 188"L x 62"W 7. ERV-12: 200"L x 87"W x 86"H; EX CURB SIZE: 228"L x 108"W 8. ERV-13: 200"L x 87"W x 86"H; EX CURB SIZE: 282"L x 86"W 9. ERV-14: 200"L x 87"W x 86"H; EX CURB SIZE: 226" x 108"W 10. ERV-15: 135"L x 64"W x 66"H; EX CURB SIZE: 202"L x 86"W 11. ERV-16: 135"L x 64"W x 66"H; EX CURB SIZE: 202"L x 86"W 12. ERV-17: 135"L x 64"W x 66"H; EX CURB SIZE: 187"L x 82"W
<p>① NOT USED</p> <p>SCALE: NONE</p>	<p>② NOT USED</p> <p>SCALE: NONE</p>	<p>③ NOT USED</p> <p>SCALE: NONE</p>	<p>④ TYP ROOFTOP ERV W/O HORIZONTAL DUCTS</p> <p>SCALE: NONE</p>
<p>⑤ NOT USED</p> <p>SCALE: NONE</p>	<p>⑥ NOT USED</p> <p>SCALE: NONE</p>	<p>⑦ NOT USED</p> <p>SCALE: NONE</p>	<p>NOTES:</p> <p>1. EX UNIT CURB DIMENSIONS ARE INDICATED ON THE DRAWINGS. EX ROOF CURBS SHALL REMAIN. NEW UNITS SHALL UTILIZE CURB ADAPTERS TO ARRANGE THE AIR FLOWS BELOW THE UNITS TO MATCH EXISTING DUCT CONNECTIONS AS REQUIRED. SOME UNITS MAY ONLY HAVE ONE DUCT CONNECTION FROM WITHIN THE CURB. EXTEND ALL PIPING WITHIN THE EXISTING CURB TO THE NEW LOCATIONS WITHIN THE NEW UNITS. UNITS WITH HORIZONTAL DUCTWORK, THE DUCTWORK IS INDICATED ON THE ROOF DRAWING. IF MANUFACTURER CANNOT BUILD THEIR UNIT WITH THE DUCT CONNECTION WHERE INDICATED THEN THEY SHALL BE RESPONSIBLE FOR ROUTING THE DUCT AS REQUIRED TO ENTER THE BUILDING AT THE SAME EX LOCATION. MANUFACTURER SHALL BE RESPONSIBLE FOR ADDITION DUCTWORK SUPPORTS AND ASSOCIATED ROOF WORK AS REQUIRED. DUCTWORK SHALL BE DOUBLE WALL PRE-INSULATED DUCTWORK WITH R-8 MINIMUM INSULATION BETWEEN A PERFORATED INNER LINER AND THE EXTERIOR SHEETMETAL. ALL JOINTS SHALL BE GASKETED. DUCT EQUAL TO THAT MANUFACTURED BY JMT.</p> <p>COMPONENTS:</p> <p>1. THE NEW UNITS SHALL BE WATER COOLED, EXTENDED RANGE GEOTHERMAL HEAT PUMP UNITS WITH FACTORY TERMINAL STRIPS FOR CONTROLS BY JOHNSON CONTROLS, INCORPORATED. UNITS SHALL HAVE THEIR ASSOCIATED HARDWIRED SAFETIES. REFER TO SPECIFICATIONS, SCHEDULES AND AUTOMATIC CONTROLS FOR ADDITIONAL INFORMATION.</p> <p>ADDITIONAL OUTSIDE AIR SIDE COMPONENTS SHALL INCLUDE:</p> <ol style="list-style-type: none"> 1. OUTSIDE AIR INTAKE PLENUM WITH ASSOCIATED HOODS AND DAMPERS. 2. OUTSIDE AIR 2" MERV 8 FILTERS UPSTREAM OF THE TOTAL ENERGY WHEEL. 3. TOTAL ENERGY WHEEL WITH BYPASSES. 4. 4" MERV 13 FINAL FILTER. 5. REFRIGERATION COIL AND ASSOCIATED CIRCUITS AND COMPRESSORS, ETC. 6. HOT GAS REHEAT COIL 7. OUTSIDE AIR SUPPLY FAN. <p>ADDITIONAL RETURN/EXHAUST AIR SIDE COMPONENTS SHALL INCLUDE:</p> <ol style="list-style-type: none"> 1. RA DAMPER. 2. 2" MERV 8 FILTERS UPSTREAM OF THE TOTAL ENERGY WHEEL. 3. EXHAUST AIR FAN. 4. EXHAUST AIR PLENUM WITH ASSOCIATED HOODS AND DAMPERS. <p>BASIS OF DESIGN UNIT SIZES:</p> <ol style="list-style-type: none"> 1. THE UNIT SIZES ARE THE TOTAL CABINET SIZE WITH ALL EQUIPMENT ENCLOSED AND IS THE SIZE OF THE UNIT SUPPORT FRAME. SIZE DOESN'T INCLUDE THE HOOD DIMENSIONS THAT DO NOT IMPACT THE CURB SIZE. 2. ERV-1: 200"L x 87"W x 86"H; EX CURB SIZE: 202"L x 86"W 3. ERV-2: 114"L x 64"W x 62"H; EX CURB SIZE: 180"L x 72"W 4. ERV-9: 200"L x 87"W x 86"H; EX CURB SIZE: 226"L x 107"W
<p>⑨ NOT USED</p> <p>SCALE: NONE</p>	<p>⑩ NOT USED</p> <p>SCALE: NONE</p>	<p>⑪ NOT USED</p> <p>SCALE: NONE</p>	<p>⑧ TYP ROOFTOP ERV W/ HORIZONTAL DUCTS</p> <p>SCALE: NONE</p> <p>NOTES:</p> <p>1. EX UNIT HOUSEKEEPING PADS SHALL BE RE-USED AND ENLARGED AS INDICATED ON THE DRAWINGS. NEW HOUSEKEEPING PADS SHALL BE PROVIDED IF INDICATED. THE DUCTWORK AND PIPING MODIFICATIONS ARE INDICATED ON THE DRAWINGS.</p> <p>COMPONENTS:</p> <p>1. THE NEW UNITS SHALL BE WATER COOLED, EXTENDED RANGE GEOTHERMAL HEAT PUMP UNITS WITH FACTORY TERMINAL STRIPS FOR CONTROLS BY JOHNSON CONTROLS, INCORPORATED. UNITS SHALL HAVE THEIR ASSOCIATED HARDWIRED SAFETIES. REFER TO SPECIFICATIONS, SCHEDULES AND AUTOMATIC CONTROLS FOR ADDITIONAL INFORMATION.</p> <p>ADDITIONAL OUTSIDE AIR SIDE COMPONENTS SHALL INCLUDE:</p> <ol style="list-style-type: none"> 1. OUTSIDE AIR INTAKE PLENUM WITH ASSOCIATED HOODS AND DAMPERS. 2. OUTSIDE AIR 2" MERV 8 FILTERS UPSTREAM OF THE TOTAL ENERGY WHEEL. 3. TOTAL ENERGY WHEEL WITH BYPASSES. 4. 4" MERV 13 FINAL FILTER. 5. REFRIGERATION COIL AND ASSOCIATED CIRCUITS AND COMPRESSORS, ETC. 6. HOT GAS REHEAT COIL 7. OUTSIDE AIR SUPPLY FAN. <p>ADDITIONAL RETURN/EXHAUST AIR SIDE COMPONENTS SHALL INCLUDE:</p> <ol style="list-style-type: none"> 1. RA DAMPER. 2. 2" MERV 8 FILTERS UPSTREAM OF THE TOTAL ENERGY WHEEL. 3. EXHAUST AIR FAN. 4. EXHAUST AIR PLENUM WITH ASSOCIATED HOODS AND DAMPERS. <p>BASIS OF DESIGN UNIT SIZES:</p> <ol style="list-style-type: none"> 1. THE UNIT SIZES ARE THE TOTAL CABINET SIZE WITH ALL EQUIPMENT ENCLOSED AND IS THE SIZE OF THE UNIT SUPPORT FRAME. 2. ERV-3: 174"L x 59"W x 88"H 3. ERV-7: 135"L x 64"W x 66"H PROVIDE WITH ADAPTER CURB FOR DOWN INLET AND DISCHARGE. 4. ERV-8: 114"L x 64"W x 62"H 5. ERV-18.1: 117"L x 63"W x 30"H, DIMENSIONS DO NOT INCLUDE THE 19"W INLET AND EXHAUST FILTER HOUSINGS.
<p>⑨ NOT USED</p> <p>SCALE: NONE</p>	<p>⑩ NOT USED</p> <p>SCALE: NONE</p>	<p>⑪ NOT USED</p> <p>SCALE: NONE</p>	<p>⑫ TYP INTERIOR ERV</p> <p>SCALE: NONE</p>


Gilbert Architects retains all intellectual property interests in the data and information on these plans. The receiver warrants that the data and information on these plans will be used only for the purposes intended and will not be used for any other purpose without the permission of Gilbert Architects.

Gipe Associates, Inc.
CONSULTING ENGINEERS
www.gipe.net
1220 East Joyce Road, Suite 233
Dover, New Jersey 07801
Tel: 908.226.2106
Fax: 908.226.2107
NJ Lic. No. 25097

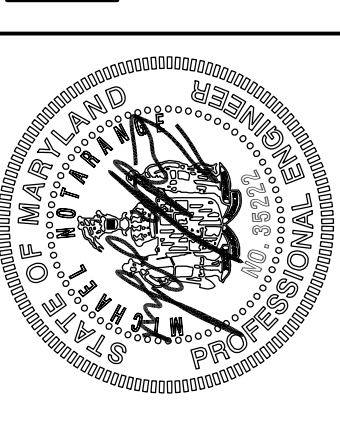


PROFESSIONAL CERTIFICATION: THESE DOCUMENTS WERE PREPARED BY ME AND I AM A LICENSED PROFESSIONAL ENGINEER OF THE STATE OF MARYLAND. LICENSE NO. 20322. EXPIRES 01/01/2028.

605 North Chesapeake Street
Lanham, PA 17603
P: 717.291.1107
200 Continental Drive, Suite 401
Pylesville, MD 21157
P: 410.388.8869

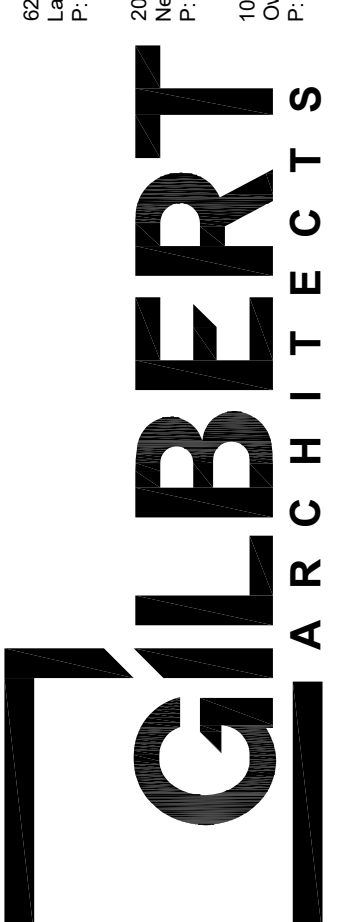

MECHANICAL DETAILS
ROOF REPLACEMENT:
NORTH HARFORD HIGH SCHOOL
HARFORD COUNTY PUBLIC SCHOOLS
PYLESVILLE, MARYLAND 21152



REVISION	DATE
1. ADDENDUM NO. 2	04/08/2020
DRAWN BY	CJW
PROJECT NO.	25097
SHEET NO.	M4.1
DATE	03/15/2020

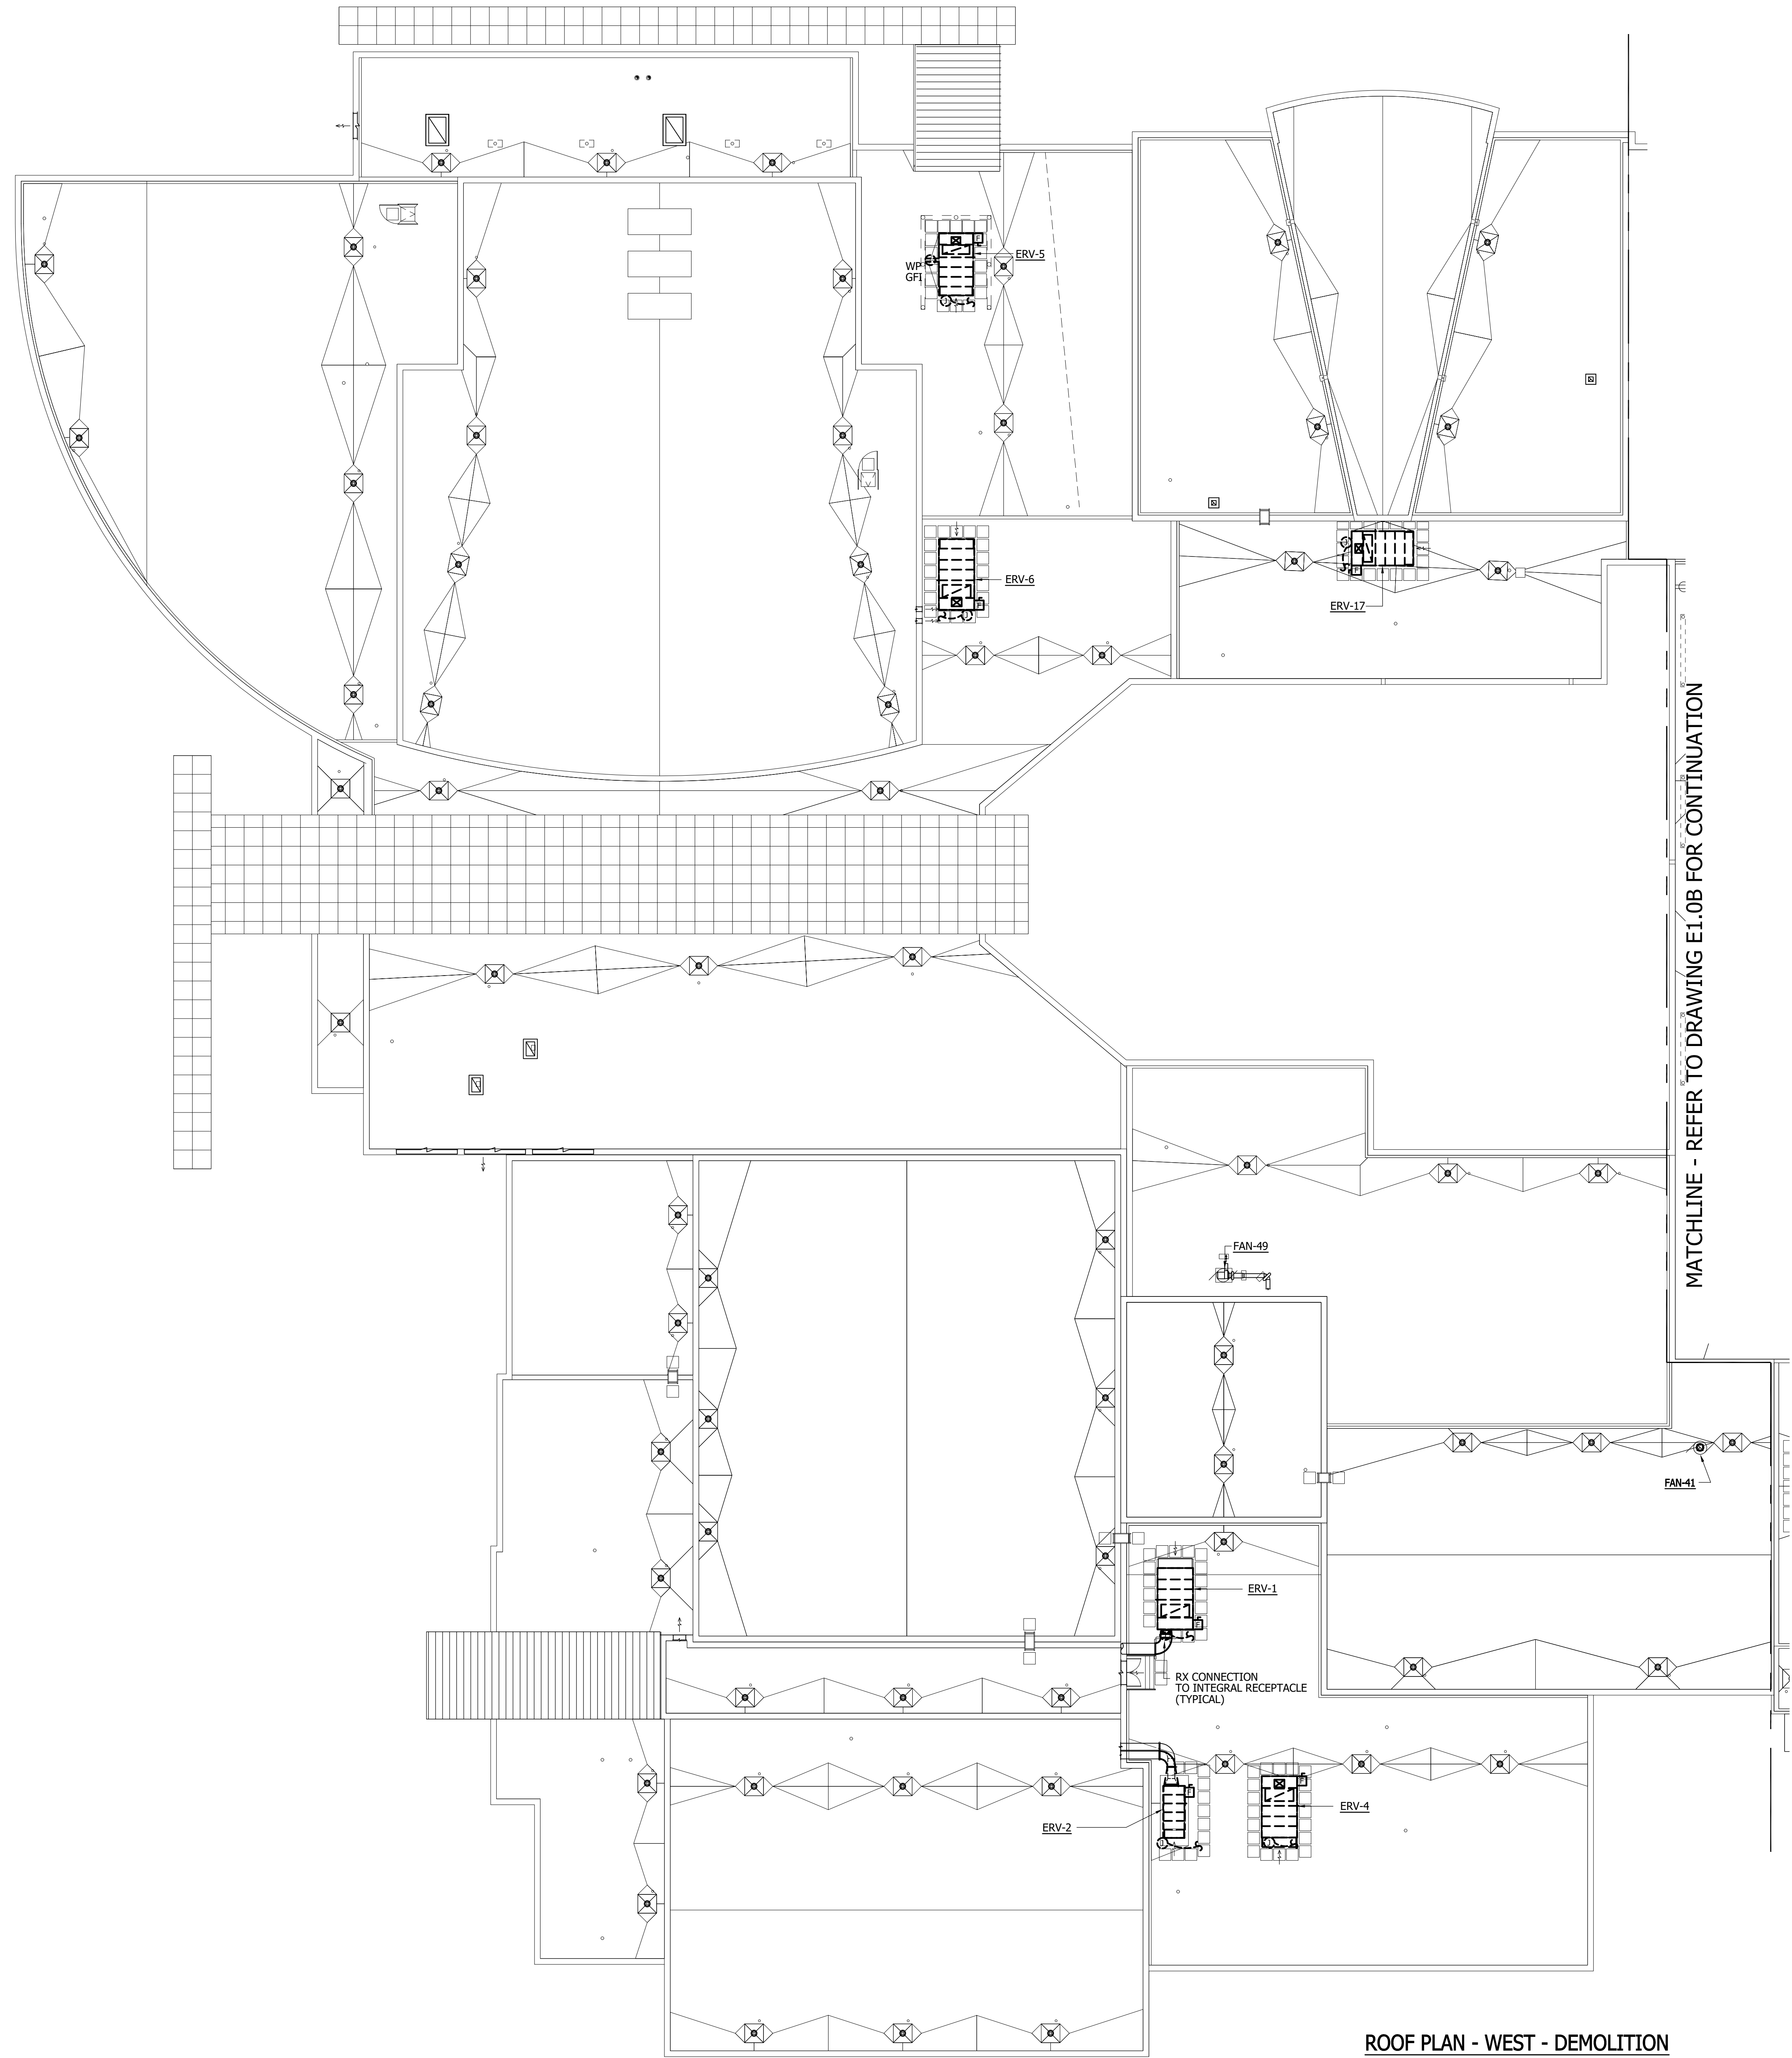

ROOF PLAN - WEST - DEMOLITION
SCALE: 1/16" = 1'-0"

DRAWING NOTES:

1. MAINTAIN EX 120V CIRCUITS FOR RECEPTACLES IN ROOFTOP UNITS FOR RECONNECTION TO NEW.

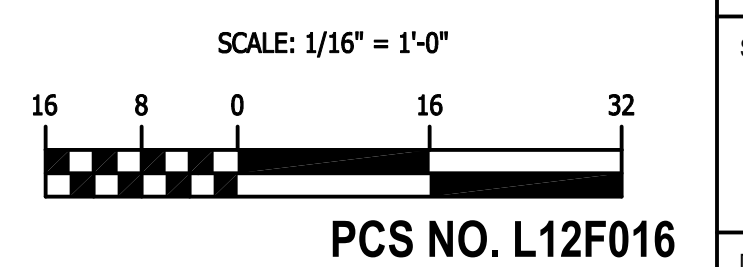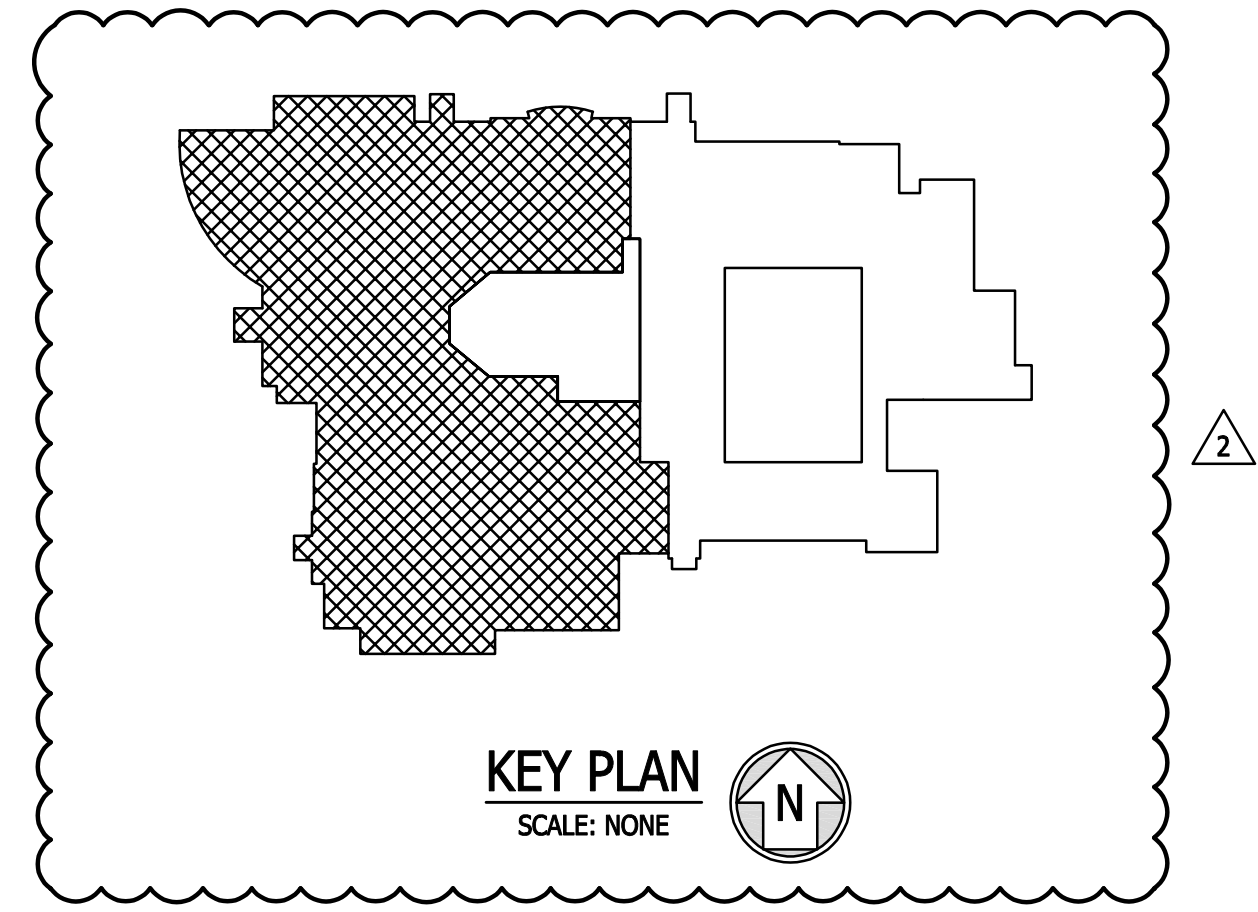

PCS NO. L12F016

ROOF PLAN - WEST - DEMOLITION
ROOF REPLACEMENT:
NORTH HARFORD HIGH SCHOOLS
HARFORD COUNTY PUBLIC SCHOOLS
PYLESVILLE, MARYLAND 21132

REVISION	DATE
2 ADDENDUM NO.2	04/08/2026

DRAWN BY: ASD
 PROJECT NO.: 25097
 SHEET NO.: **E1.0A**
 DATE: 03/15/2026

GILBERT ARCHITECTS


PROFESSIONAL
 THESE DOCUMENTS WERE
 PREPARED BY ME OR UNDER
 MY CLOSE PERSONAL SUPERVISION
 AND I AM A DULY LICENSED PROFESSIONAL ENGINEER
 OF THE STATE OF MARYLAND.
 PROJECT NO. 25097
 EXPIRATION DATE:
 12/31/2027

608 North Chesapeake Street
 Lanesboro, PA 17653
 P: 717-251-1177
 200 Conestoga Drive, Suite 401
 Pylesville, MD 21153
 P: 410-383-3300
 10451 Mill Run Circle, Suite 400
 Dumbarton Hills, MD 21117
 P: 410-262-8266



Gipe Associates, Inc.
 CONSULTING ENGINEERS
 www.gipe-inc.com
 1220 East Joyce Road, Suite 222
 410-832-2420
 Baltimore, Maryland
 W.D. # 25097

*THIS DRAWING AND THE DESIGN AND CONSTRUCTION THEREOF ARE THE SOLE PROPERTY OF GIPE ASSOCIATES, INC. AND SHALL NOT BE REPRODUCED OR RELEASED IN ANY MANNER WITHOUT THE WRITTEN PERMISSION OF GIPE ASSOCIATES, INC. Copyright © 2025

Gilbert Architects retains all intellectual property interests in the data and information on these drawings. No part of these drawings may be reproduced, distributed, or otherwise make use of the data or information contained hereon without the written permission of Gilbert Architects.

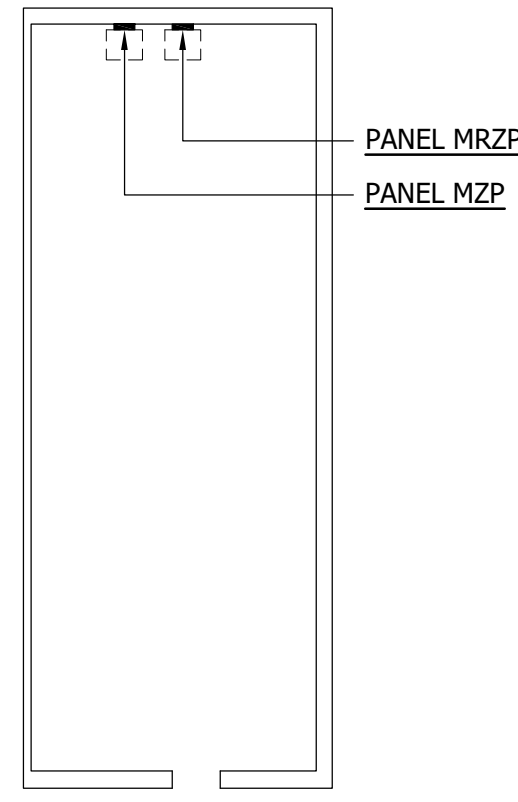

PART PLAN - KITCHEN MEZZANINE
SCALE: 1/16" = 1'-0"

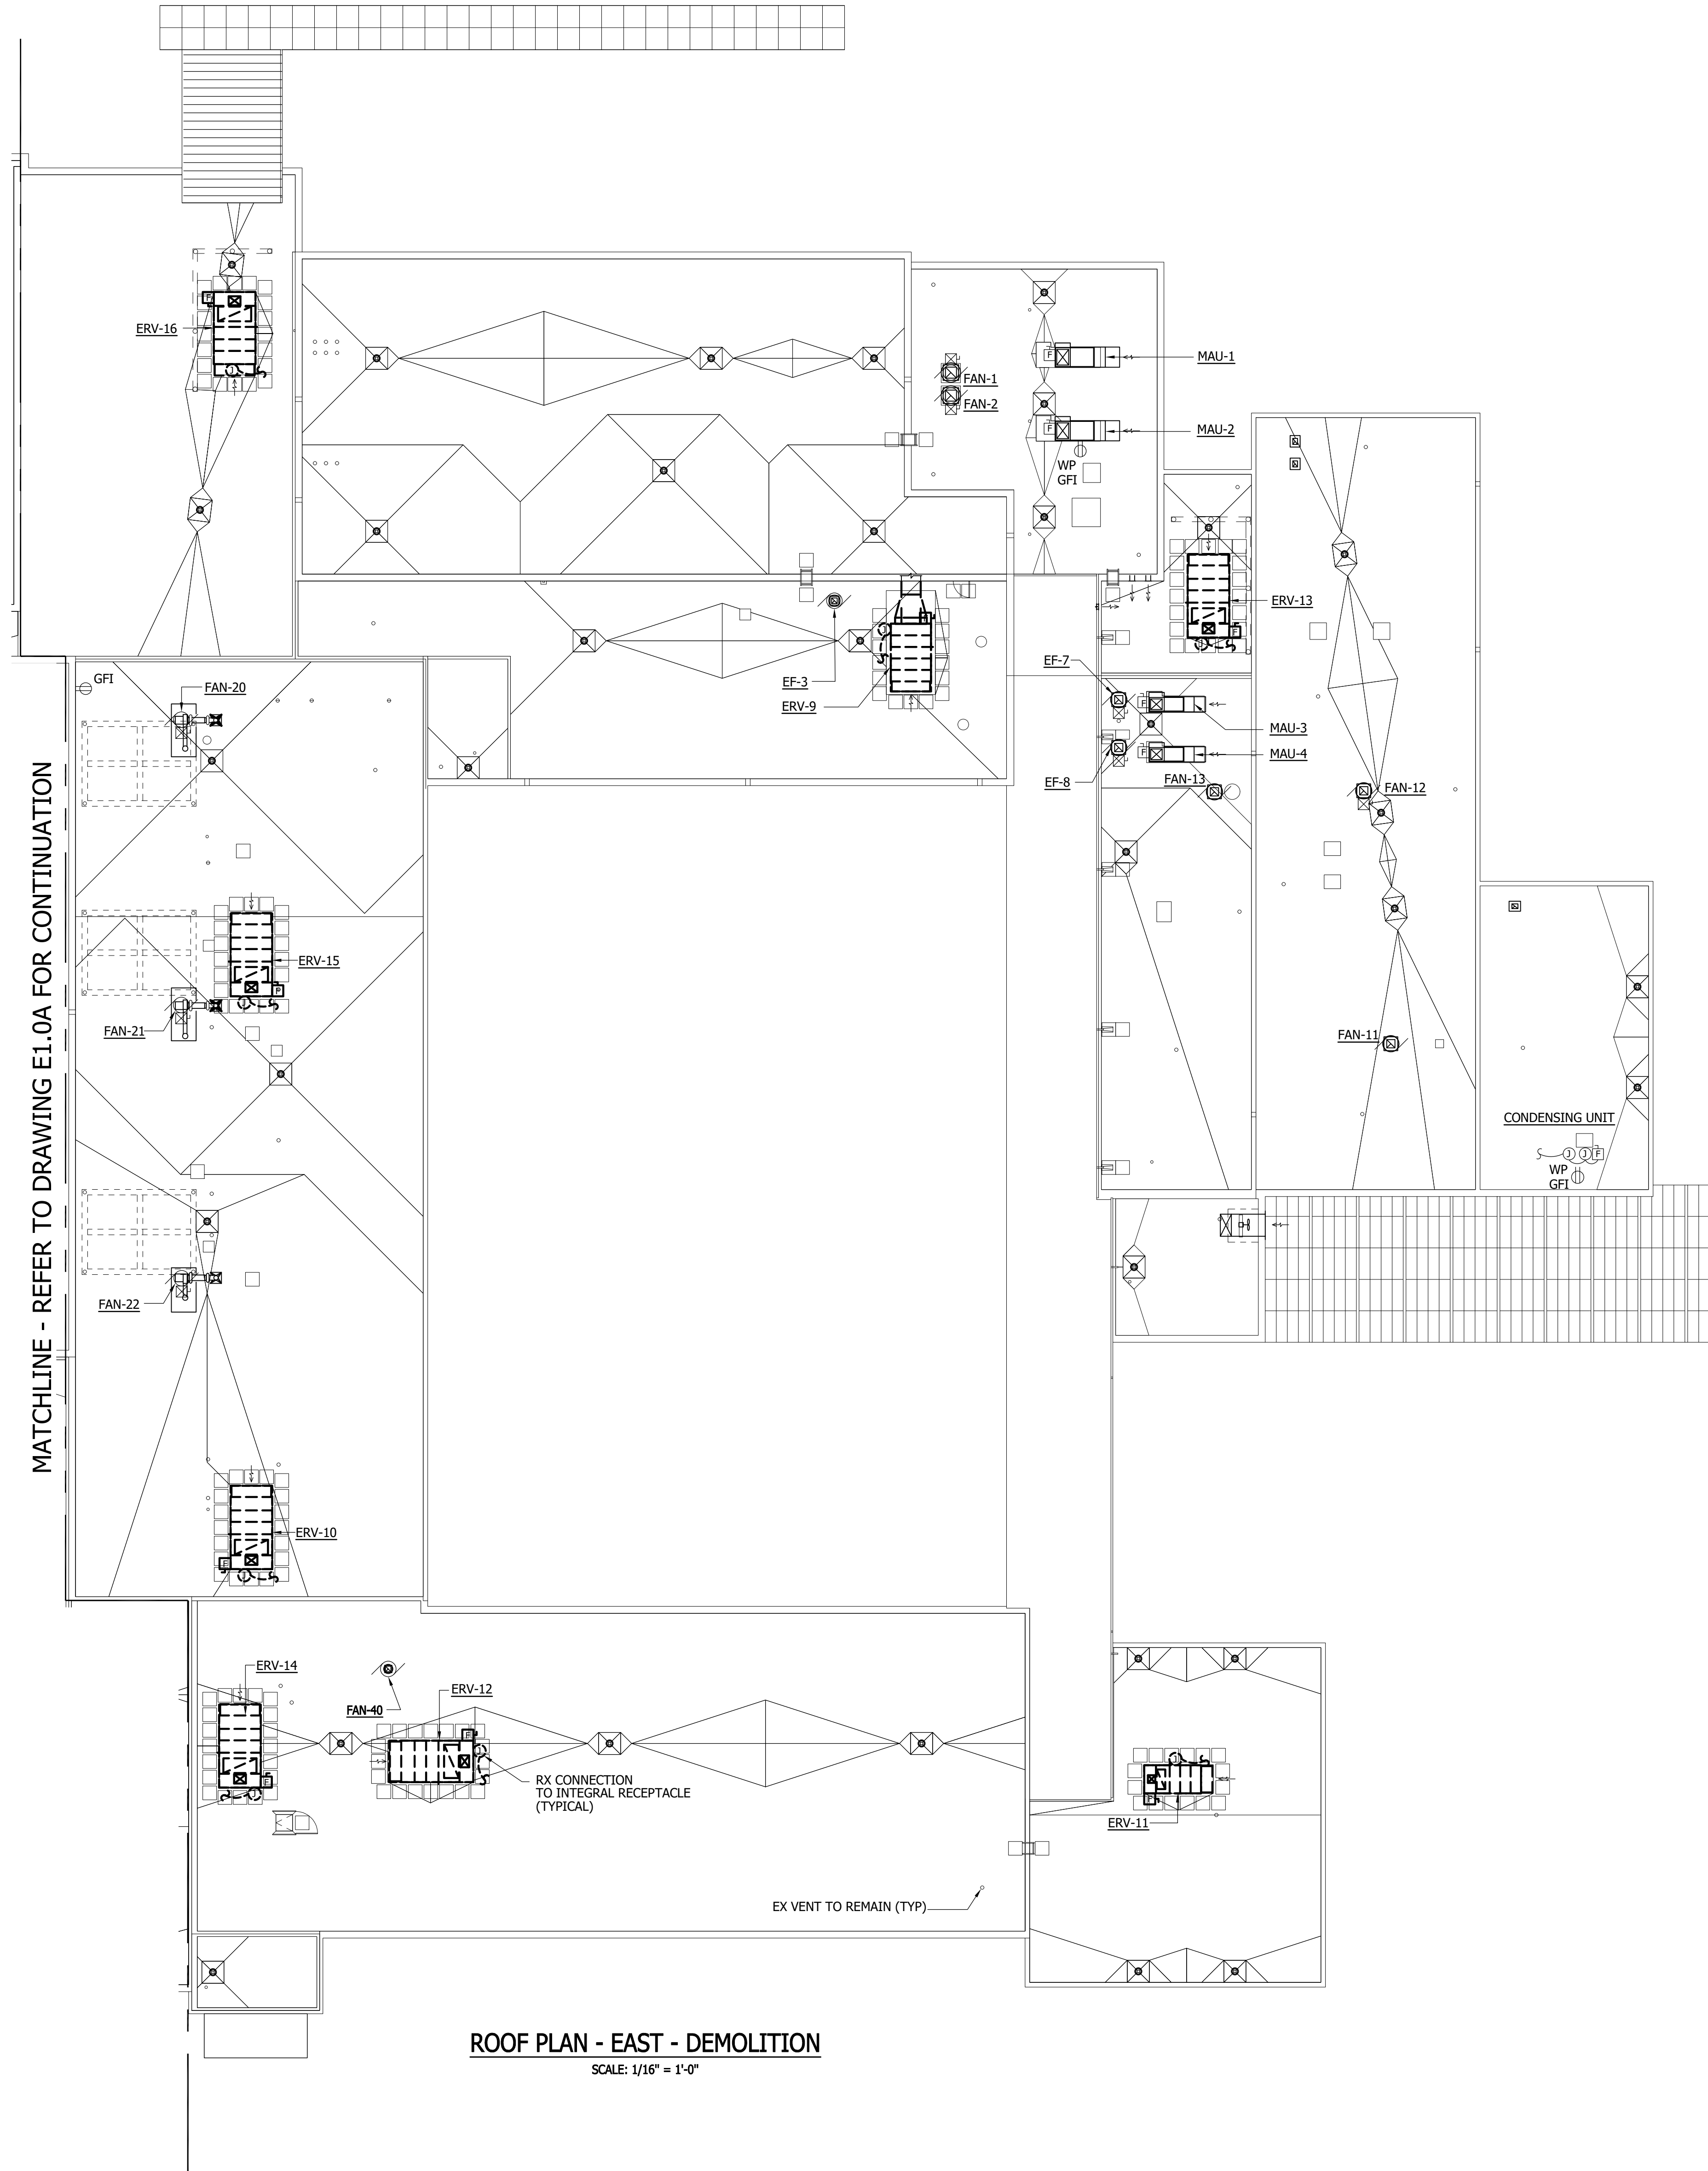
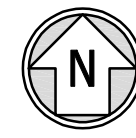


ROOF PLAN - EAST - DEMOLITION
SCALE: 1/16" = 1'-0"

MATCHLINE - REFER TO DRAWING E1.0A FOR CONTINUATION

DRAWING NOTES:


1. MAINTAIN EX 120V CIRCUITS FOR RECEPTACLES IN ROOFTOP UNITS FOR RECONNECTION TO NEW.

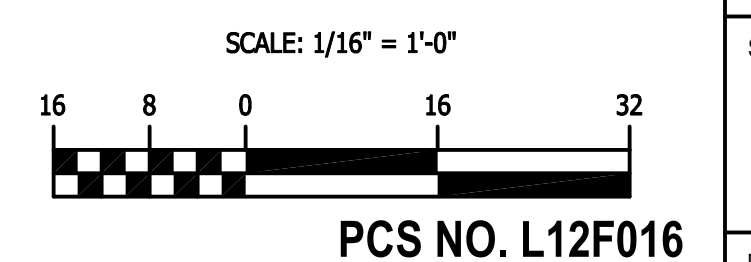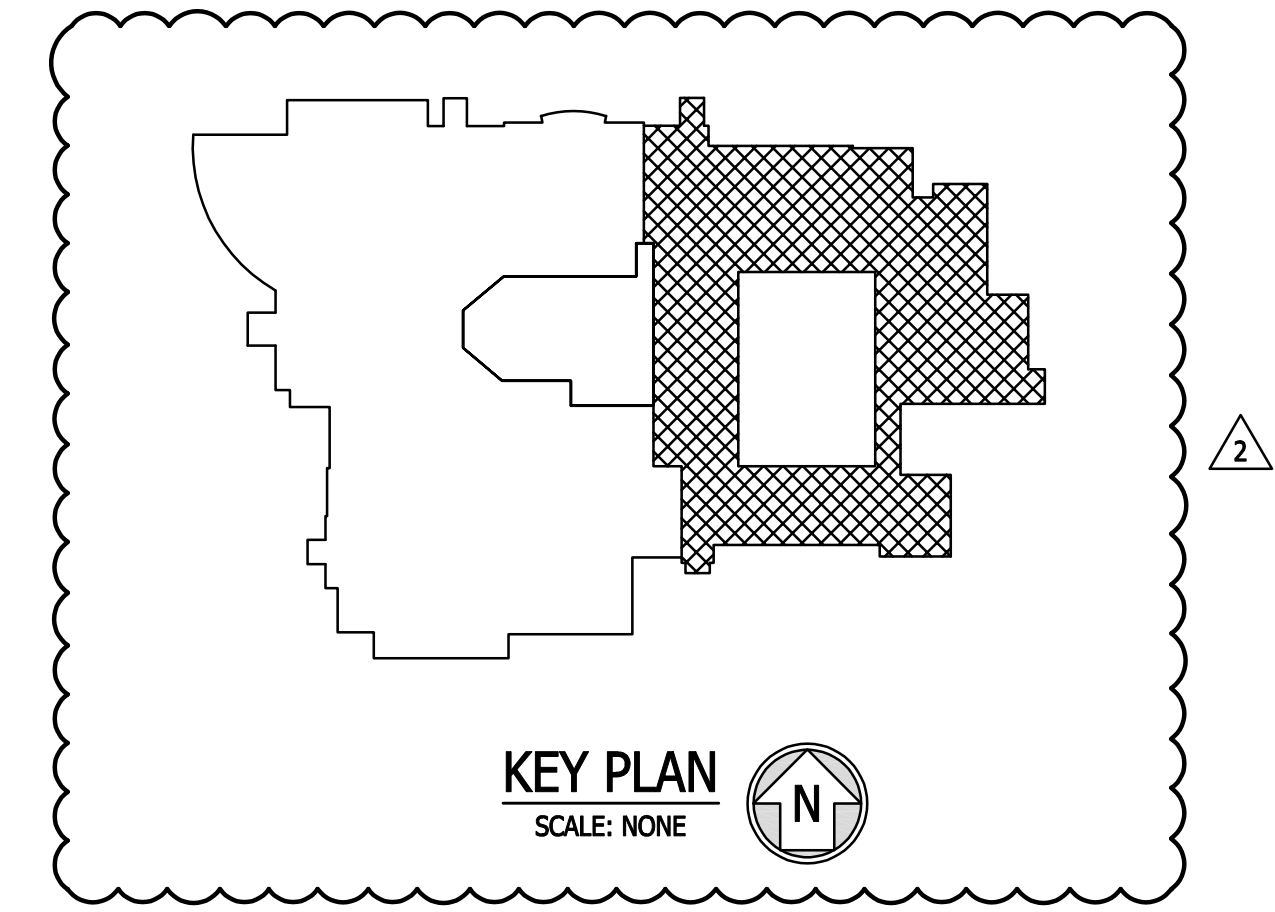

PCS NO. L12F016

Gilbert Architects retains all intellectual property interests in the data and information on these drawings. It is not to be reproduced, distributed, or otherwise make use of the data or information without the written permission of Gilbert Architects.

Gipe Associates, Inc.
CONSULTING ENGINEERS
www.gipe-inc.com
1220 East Joyce Road, Suite 222
410-832-2420
Baltimore, Maryland 21286
410-832-8868
W.D. # 25097

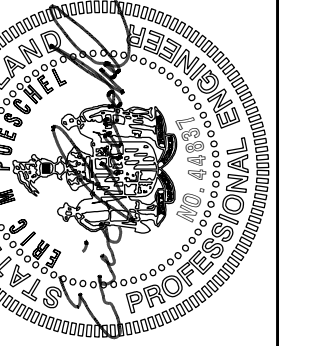

PROFESSIONAL ENGINEER
I HEREBY CERTIFY THAT THESE DOCUMENTS WERE PREPARED BY ME OR UNDER MY CLOSE PERSONAL SUPERVISION AND THAT I AM A DULY LICENSED PROFESSIONAL ENGINEER OF THE STATE OF MARYLAND.
DATE OF PREPARATION: 12/27/2027

608 North Chesapeake Street
Laneshaw, PA 17603
P: 717-251-1177
200 Connersville Drive, Suite 401
P: 410-326-5200
10451 MB Row, Crisp, Suite 400
Dumfries Hills, MD 21117
P: 410-326-5205



ROOF PLAN - EAST - DEMOLITION
ROOF REPLACEMENT:
NORTH HARFORD HIGH SCHOOLS
HARFORD COUNTY PUBLIC SCHOOLS
PYLESVILLE, MARYLAND 21132


REVISION	DATE
2 ADDENDUM NO.2	04/08/2026

DRAWN BY: ASD

PROJECT NO.: 25097

SHEET NO.: E1.0B

DATE: 03/15/2026


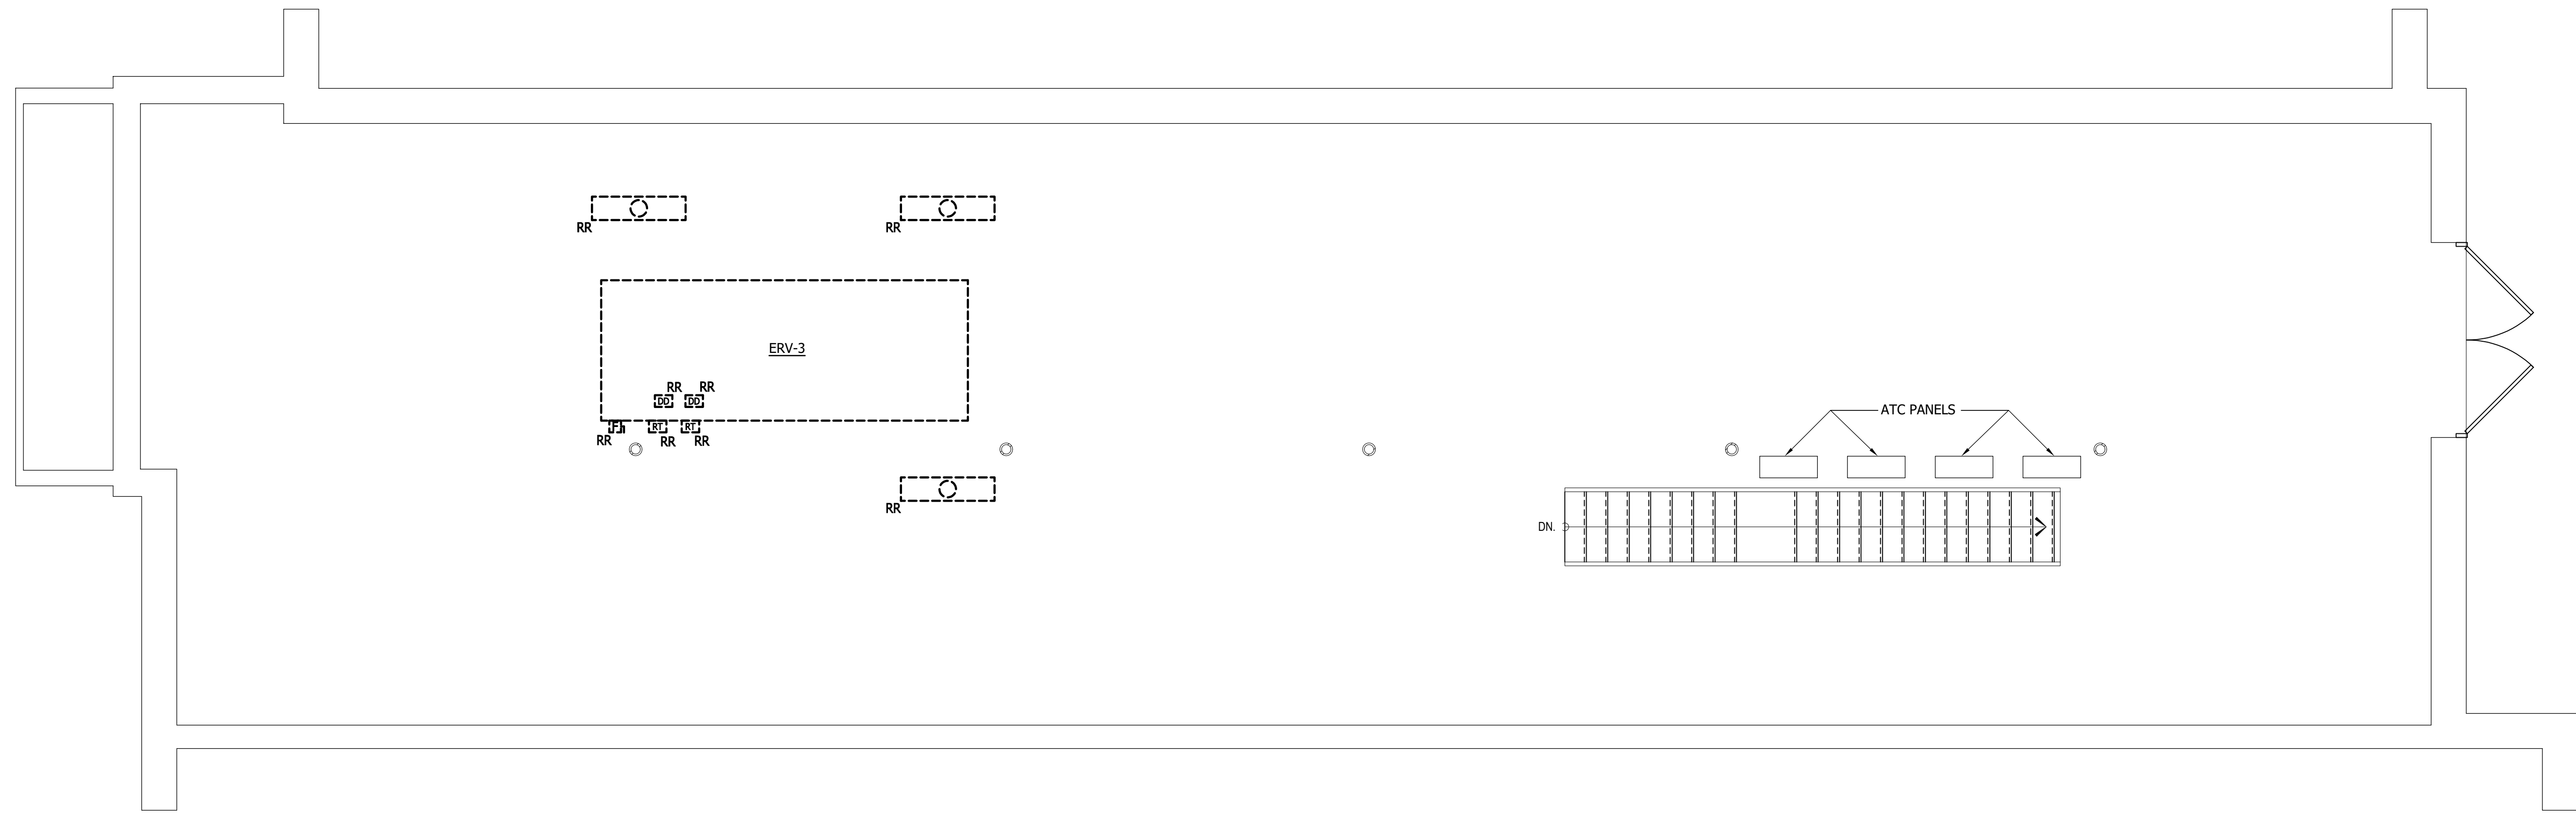


MECHANICAL ROOM - F214 - DEMOLITION

SCALE: 1/4" = 1'-0"

GENERAL NOTES:

1. HVAC UNITS INDICATED TO BE REMOVED WILL BE REMOVED UNDER MECH DIVISION. REMOVE ASSOCIATED ELECTRICAL WORK BACK TO POINT OF SOURCE.
2. REMOVE AND STORE EXISTING LIGHTS AND OTHER CEILING MOUNTED DEVICES AS REQUIRED TO ACCOMMODATE MECHANICAL WORK. REINSTALL AFTER MECHANICAL WORK IS COMPLETE UON. GENERAL SCOPE IS INDICATED.

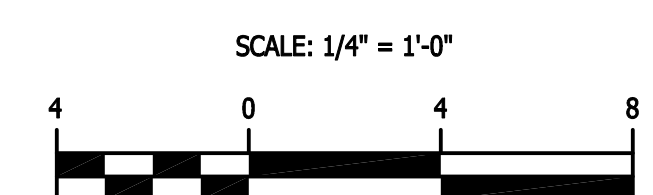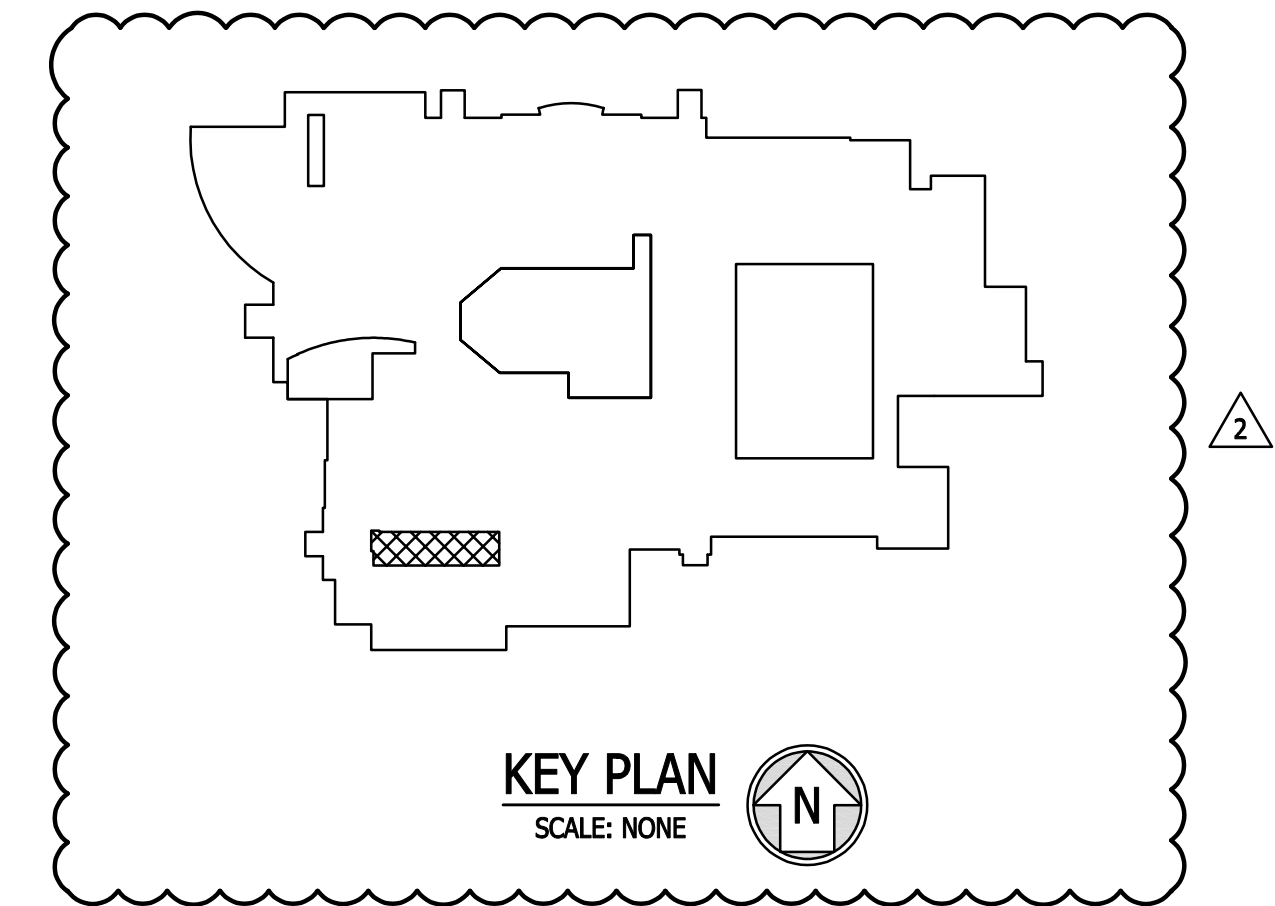

PCS NO. L12F016

PART PLAN - MECHANICAL ROOM - F214 - DEMOLITION
ROOF REPLACEMENT:
NORTH HARFORD HIGH SCHOOL
HARFORD COUNTY PUBLIC SCHOOLS
PYLESVILLE, MARYLAND 21132

REVISION
 2 ADDENDUM NO.2 04/08/2026

DRAWN BY ASD

PROJECT NO. 25097


SHEET NO.

E1.2

DATE 03/15/2026


PROFESSIONAL
 THESE DOCUMENTS WERE
 PREPARED BY ME AND I AM A DULY
 LICENSED PROFESSIONAL ENGINEER
 OF THE STATE OF MARYLAND.
 EXPIRATION DATE:
 12/31/2027

608 North Chesapeake Street
 Lanesville, PA 17033
 P: 717-251-1127
 200 Commercial Drive, Suite 401
 Pylesville, MD 21132
 P: 410-326-5256
 10451 Mill Run Circle, Suite 400
 Dumps Mills, MD 21117
 P: 410-326-5256

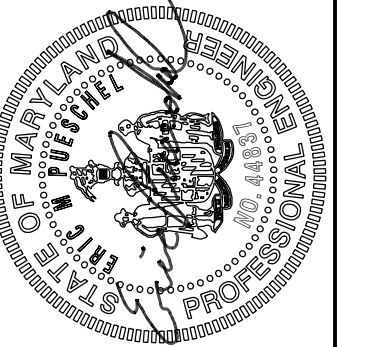

Gipe Associates, Inc.
 CONSULTING ENGINEERS
 www.gipe-inc.com
 1220 East Joyce Road, Suite 223
 410-832-2420
 Pylesville, Maryland 21132
 W.O. # 25097
 THIS SEALING AND THE ASSOCIATED CONTRACTS ARE VALID UNLESS OTHERWISE NOTED OR REVISED IN WRITING BY GIPES ASSOCIATES, INC. AND SHALL NOT BE A SOURCE OF REVENUE IN ASSOCIATION WITH THE PROFESSION OF GPE

Gilbert Architects retains all intellectual property interests in the data and information on these drawings. It is the responsibility of the user to protect, distribute, or otherwise make use of the data or information on these drawings. © Gilbert Architects.


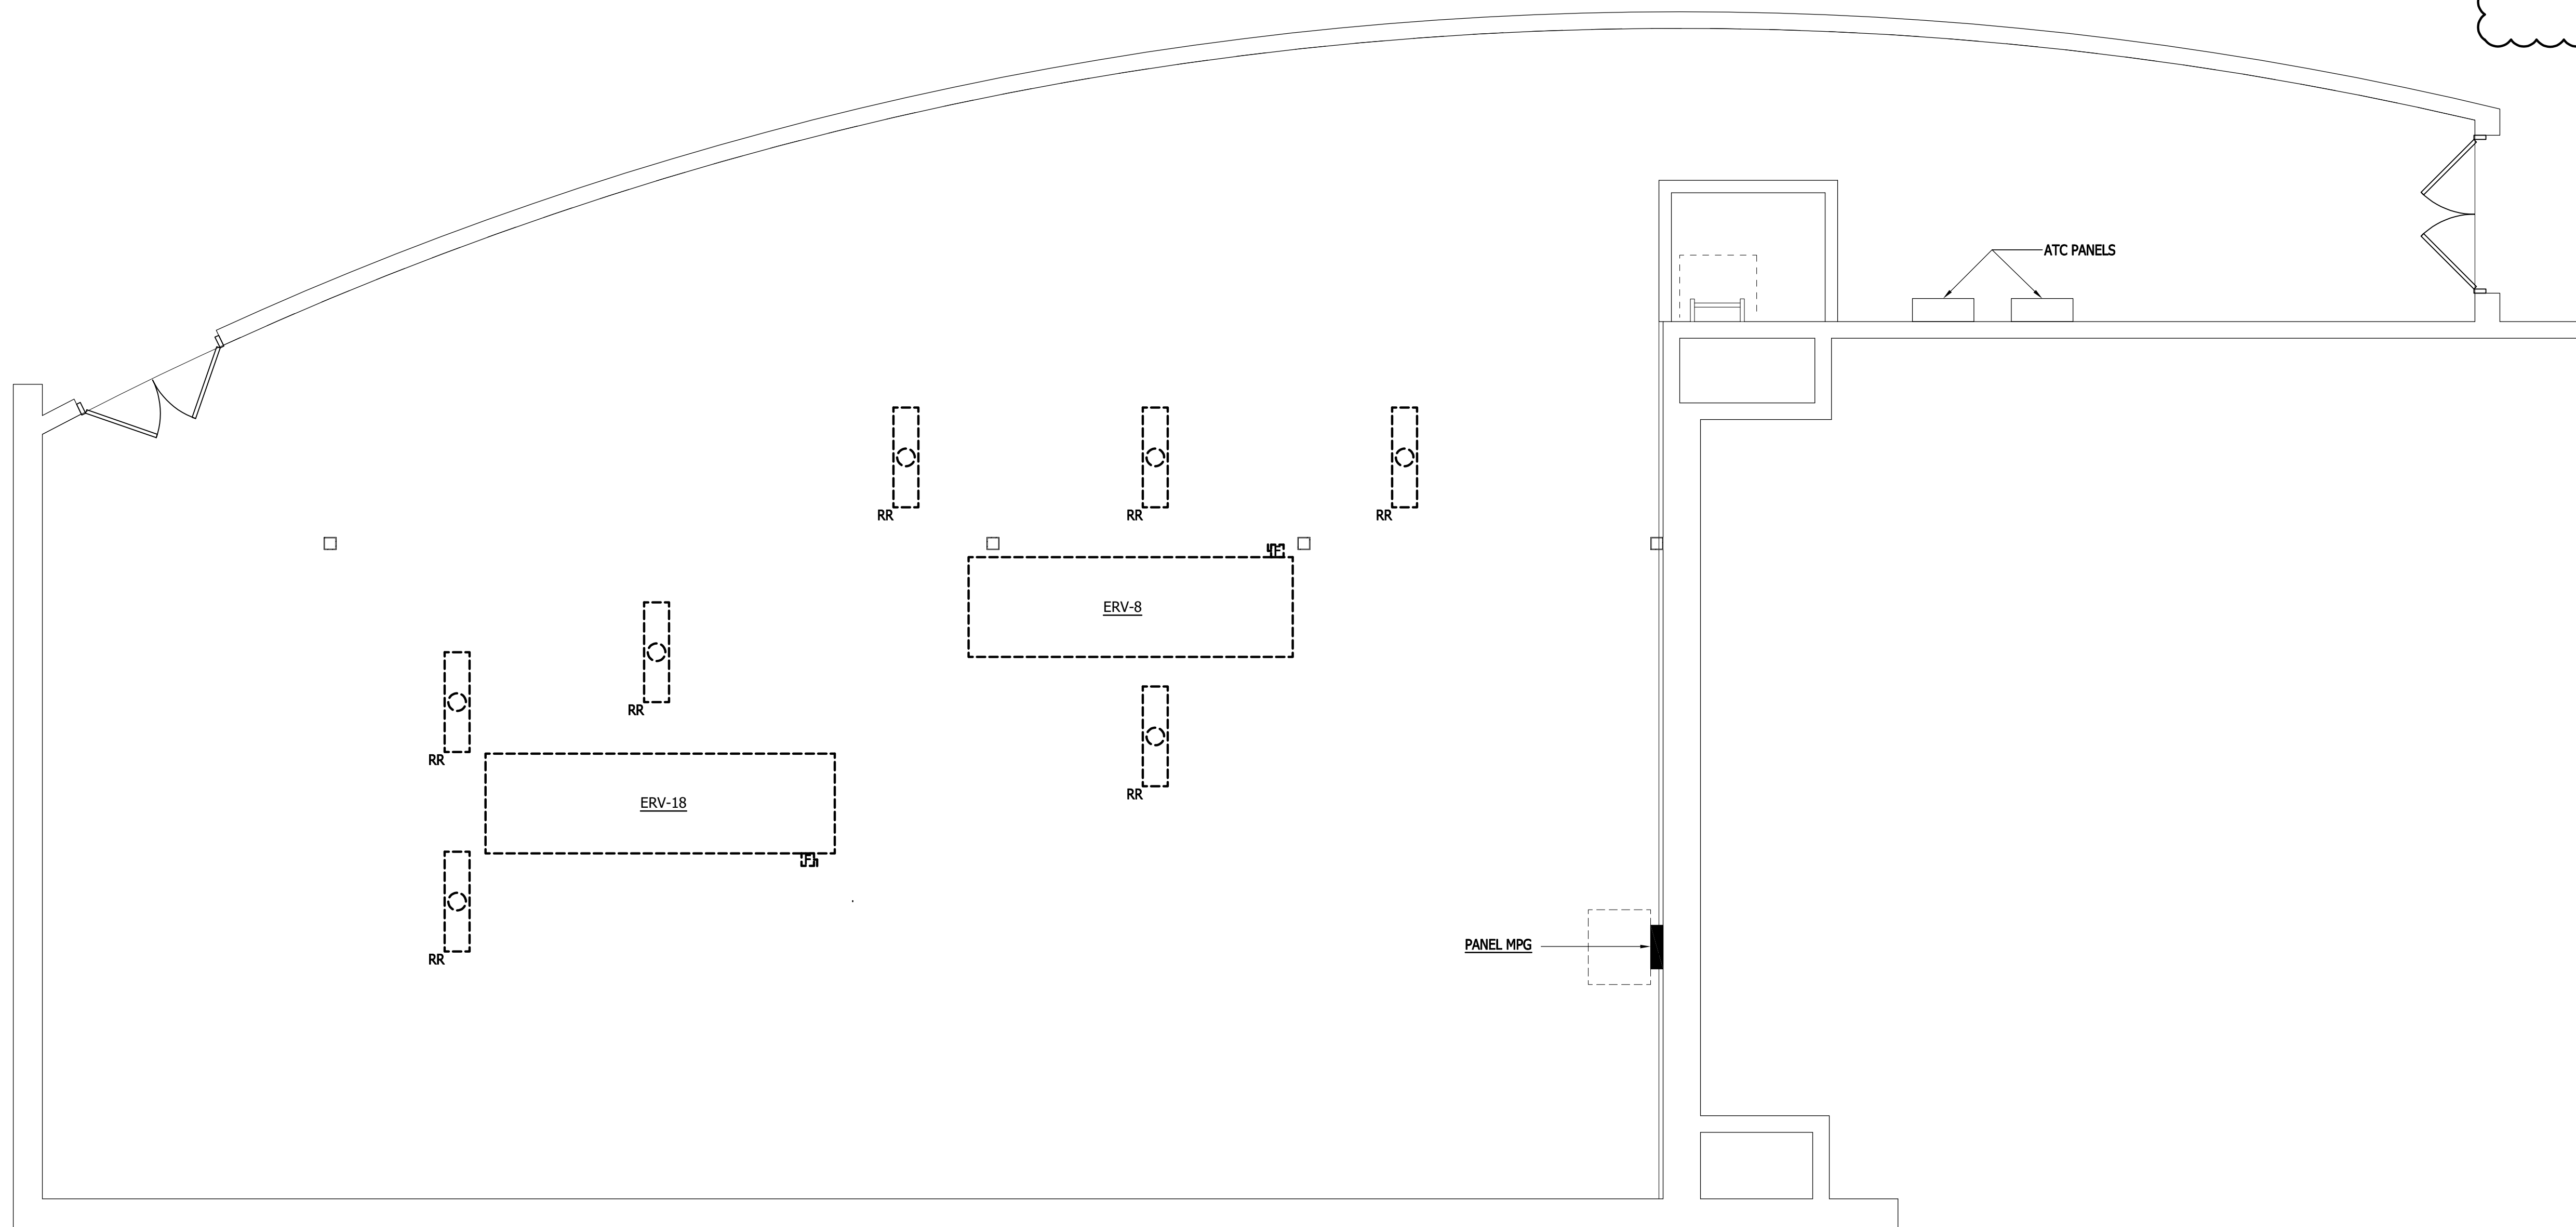


MECHANICAL ROOM - G300 - DEMOLITION

SCALE: 1/4" = 1'-0"


GENERAL NOTES:

- HVAC UNITS INDICATED TO BE REMOVED WILL BE REMOVED UNDER MECH DIVISION. REMOVE ASSOCIATED ELECTRICAL WORK BACK TO POINT OF SOURCE.
- REMOVE AND STORE EXISTING LIGHTS AND OTHER CEILING MOUNTED DEVICES AS REQUIRED TO ACCOMMODATE MECHANICAL WORK. REINSTALL AFTER MECHANICAL WORK IS COMPLETE UON. GENERAL SCOPE IS INDICATED.

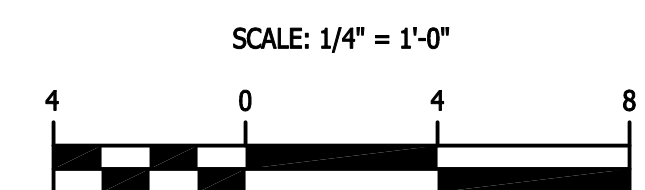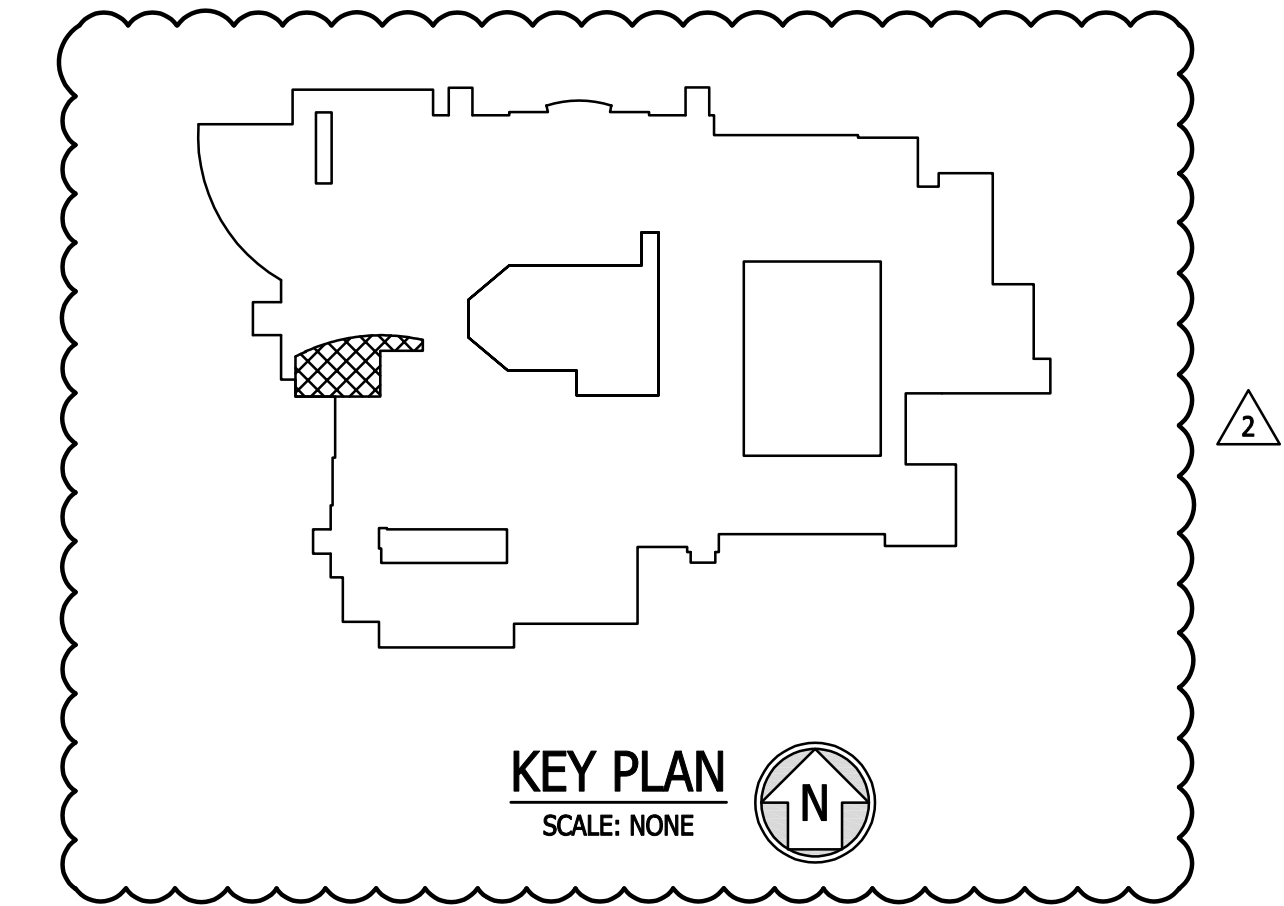


Gilbert Architects retains all ownership, copyright, and other rights in the data and information on these plans. The receiver warrants that the data and information on these plans were obtained from the plans and drawings and that the receiver will not use the data or information on these plans without the permission of Gilbert Architects.

Gipe Associates, Inc.
CONSULTING ENGINEERS
www.gipe.net
1270 Lee Avenue, Suite 225
Baltimore, Maryland 21206
Phone: 410.832.2400
Fax: 410.832.8668
W.C. # 25097
PROFESSIONAL ENGINEER LICENSE NO. 1202/2027
ASSOCIATE ENGINEER LICENSE NO. 1202/2027

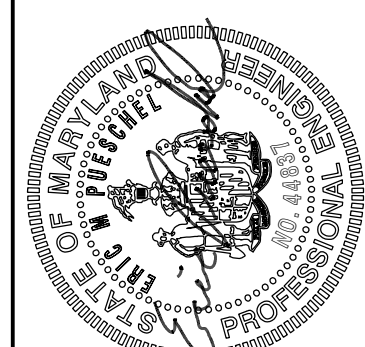

PROFESSIONAL CERTIFICATION: THESE DOCUMENTS WERE PREPARED BY AND FOR A LICENSED PROFESSIONAL ENGINEER OF THE STATE OF MARYLAND. LICENSE NO. 44807 EXPIRES 12/31/2027

100 North Chesapeake Street
Lanham, PA 17631
P: 717.291.1077
200 Commercial Drive, Suite 401
Pylesville, MD 21157
P: 410.336.8500
1450 North Lincoln Street, Suite 400
Pylesville, MD 21157
P: 410.336.8506

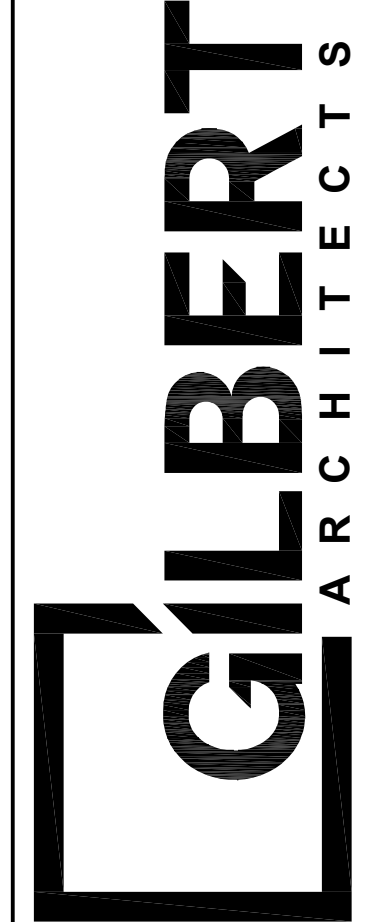

PART PLAN - MECHANICAL ROOM - G300 - DEMOLITION
ROOF REPLACEMENT:
NORTH HARFORD HIGH SCHOOL
HARFORD COUNTY PUBLIC SCHOOLS
PYLESVILLE, MARYLAND 21132

2 ADDENDUM NO. 2 04/08/2020

DRAWN BY ASD


PROJECT NO. 25097

SHEET NO.

E1.3

DATE 03/15/2026

PCS NO. L12F016

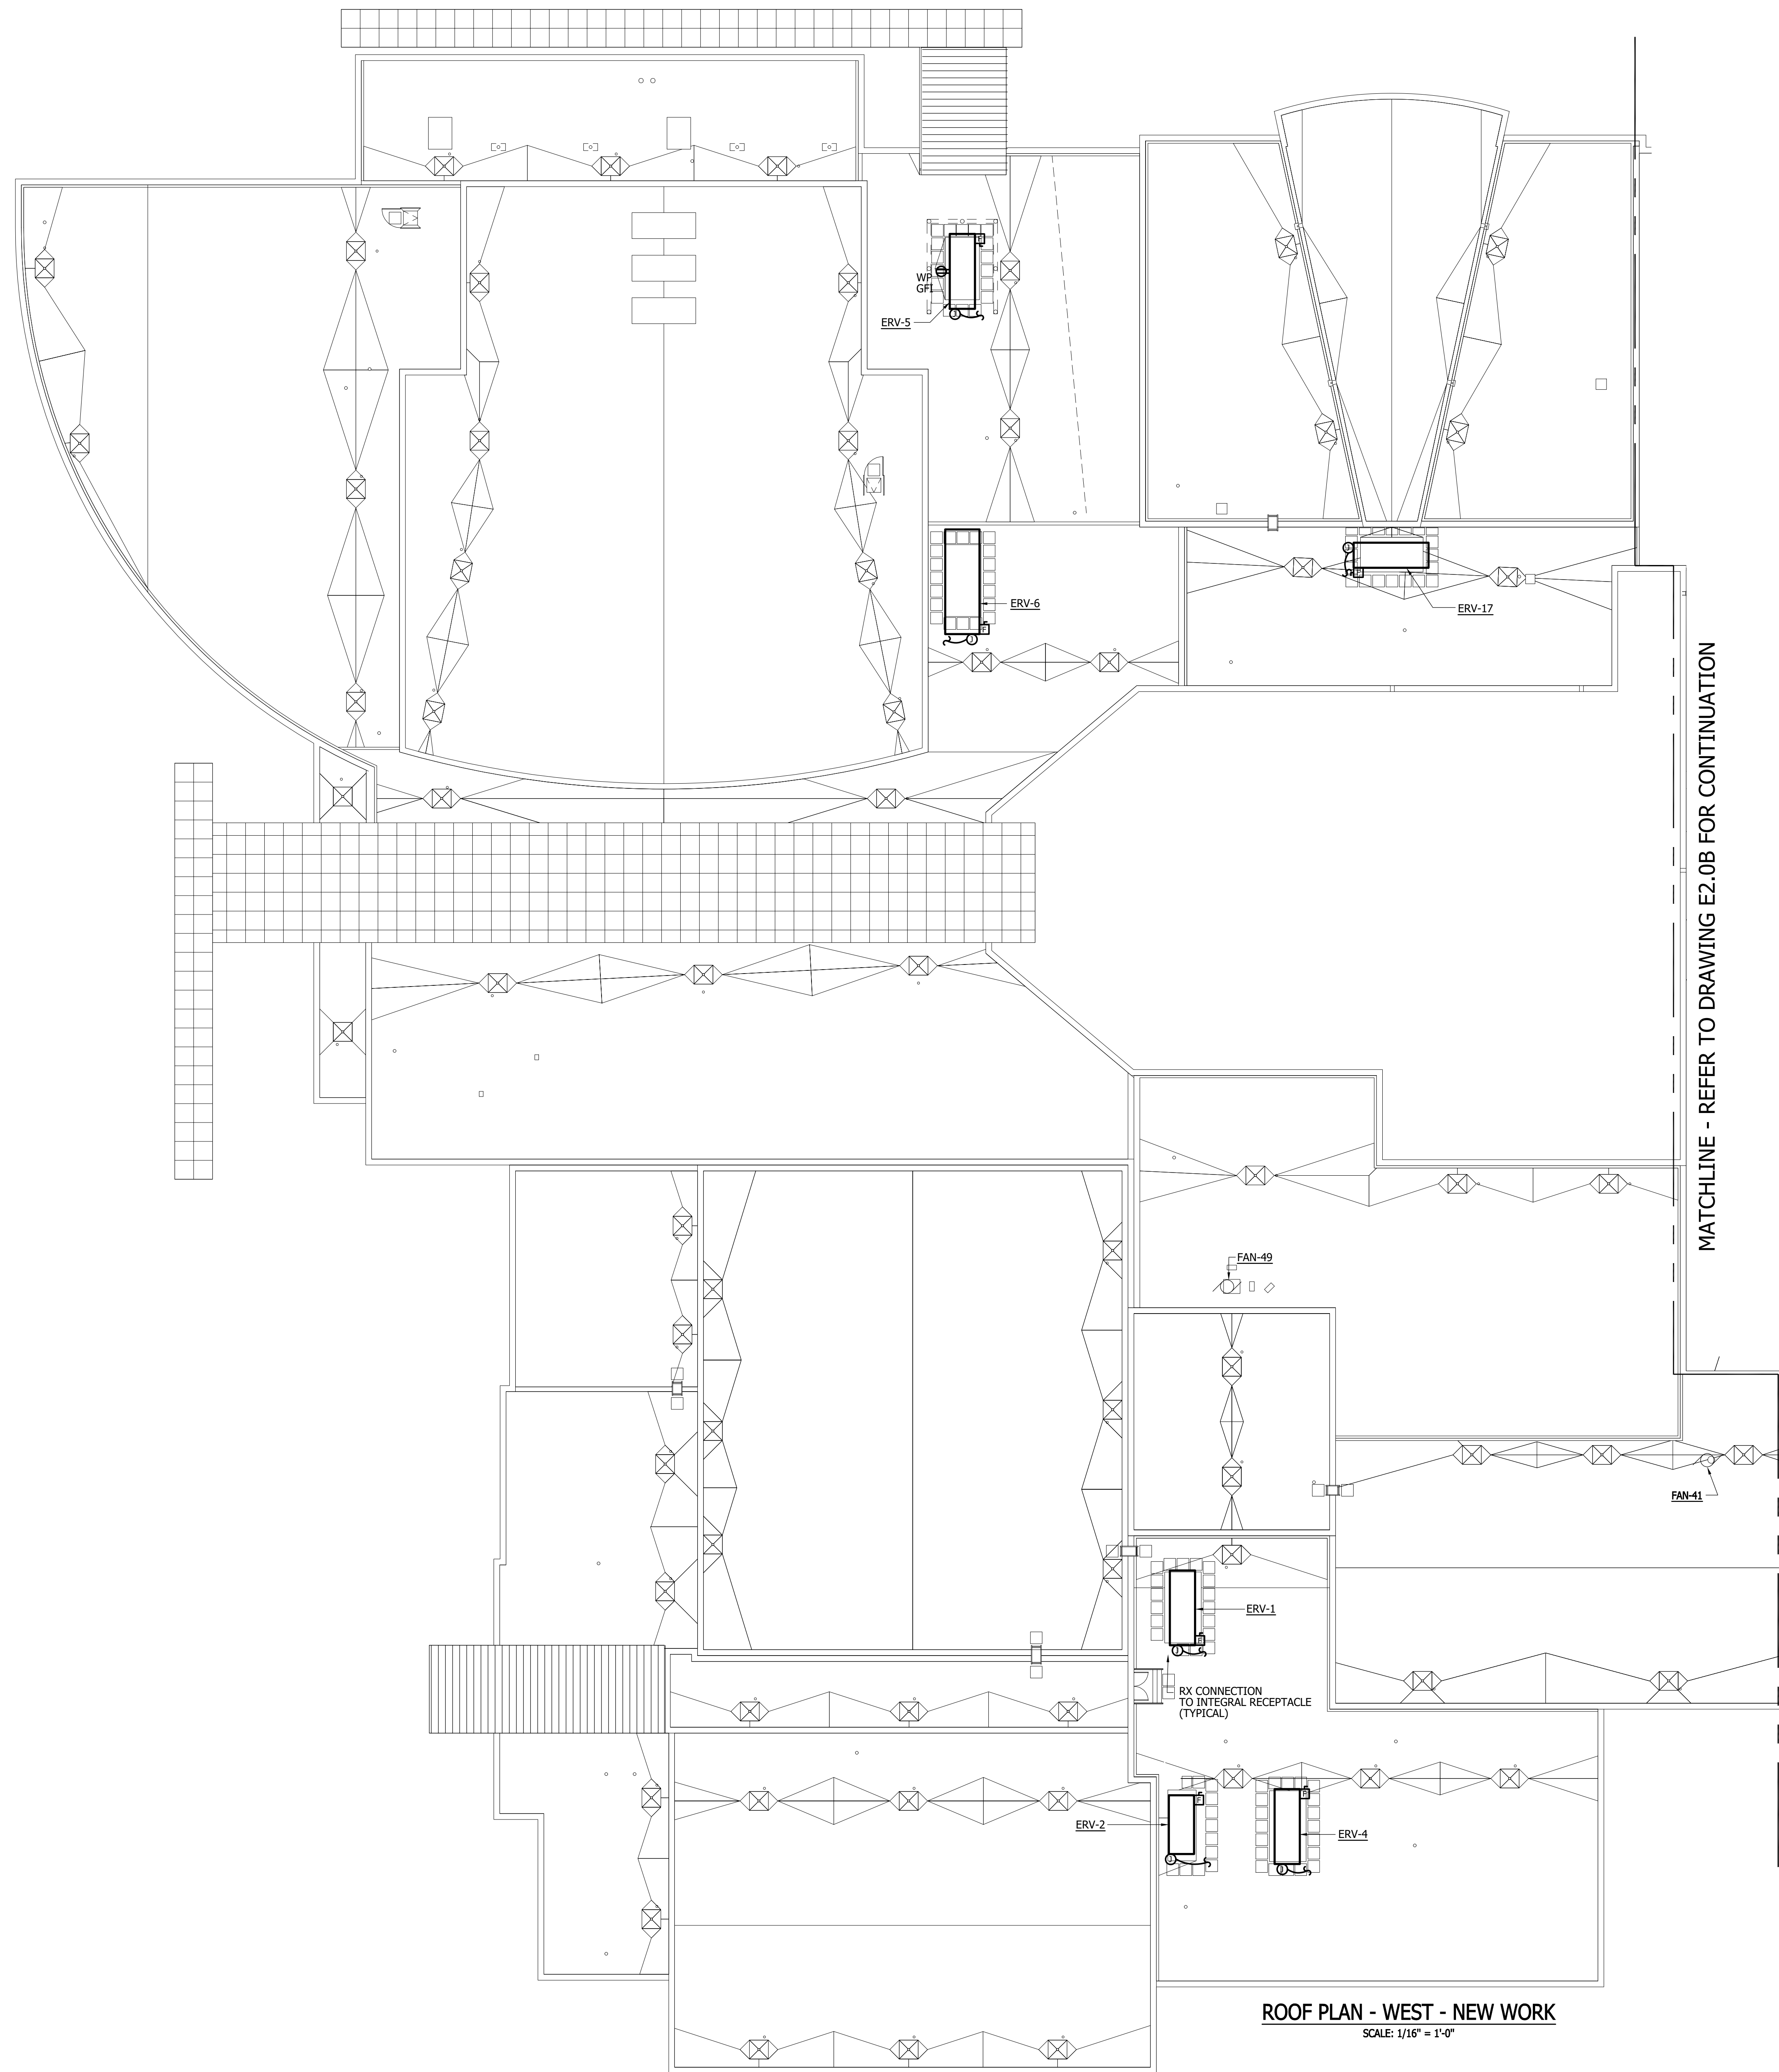


MATCHLINE - REFER TO DRAWING E2.0B FOR CONTINUATION


ROOF PLAN - WEST - NEW WORK
SCALE: 1/16" = 1'-0"

DRAWING NOTES:

1. REFER TO MECHANICAL EQUIPMENT CONNECTION SCHEDULE, DRAWING E6.4, FOR ADDITIONAL INFORMATION.
2. MAKE CONNECTION TO RECEPTACLE INTEGRAL IN ERV UNITS FROM EXISTING MAINTAINED CIRCUIT AS REQUIRED. REFER TO DEMOLITION DRAWINGS.

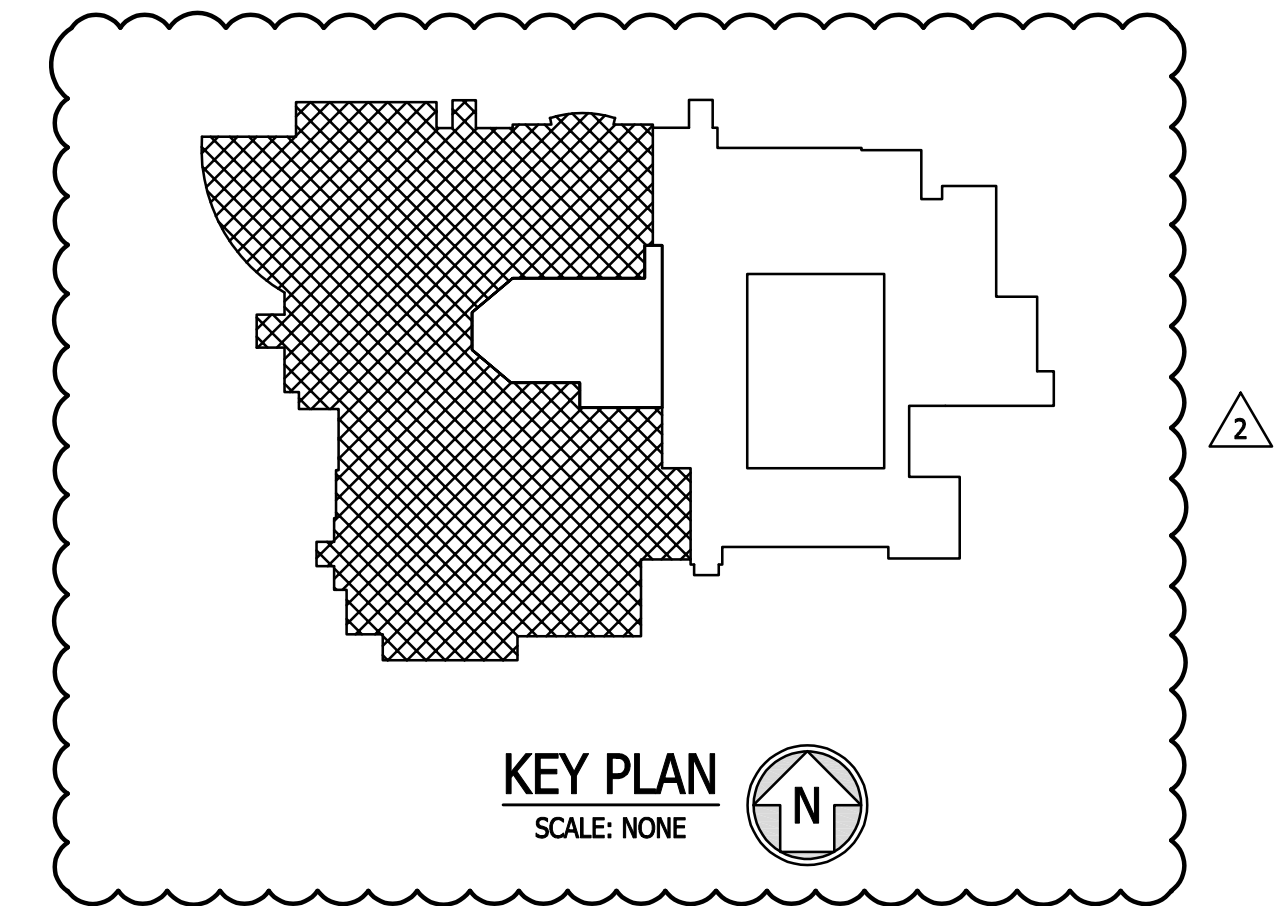


KEY PLAN
SCALE: NONE

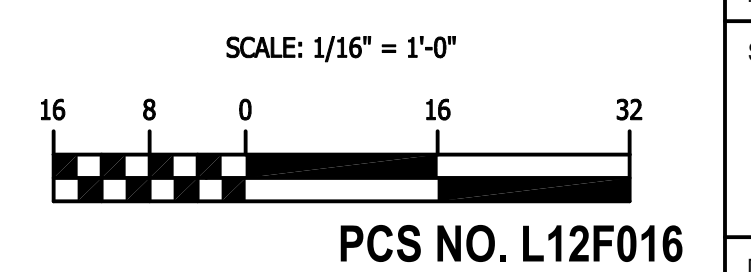

PCS NO. L12F016

<p style="font-size: 8px;">Gilbert Architects retains all intellectual property interests in the data and information on these drawings. It is not to be reproduced, distributed, or otherwise make use of the data or information without the written permission of Gilbert Architects.</p>	<p style="font-size: 8px;">Gipe Associates, Inc. CONSULTING ENGINEERS www.gipe-inc.com 1220 East Joyce Road, Suite 223 410-832-2420 Baltimore, Maryland 21206 W.D. # 25097</p> <p style="font-size: 6px;">*THIS DRAWING AND THE DESIGN AND CONTRACTS ARE THE PROPERTY OF GIPE ASSOCIATES, INC. AND SHALL NOT BE REPRODUCED OR USED IN ANY MANNER WITHOUT THE WRITTEN PERMISSION OF GIPE ASSOCIATES, INC. Copyright © 2020*</p>									
<p style="font-size: 8px;">PROFESSIONAL ENGINEER I HEREBY CERTIFY THAT THESE DOCUMENTS WERE PREPARED BY ME OR UNDER MY CLOSE PERSONAL SUPERVISION AND THAT I AM A DULY LICENSED PROFESSIONAL ENGINEER OF THE STATE OF MARYLAND. DATE OF EXAMINATION: 12/27/2017 EXPIRATION DATE: 12/27/2027</p>										
<p style="font-size: 8px;">608 North Chesapeake Street Lansdale, PA 17033 P: 717-271-1217 200 Commercial Drive, Suite 401 Pylesville, MD 21152 P: 302-383-1300</p> <p style="font-size: 8px;">10401 Mill Run Circle, Suite 400 Dumfries Hills, MD 21117 P: 410-266-2626</p>	 <p style="font-size: 12px; margin: 0;">GILBERT ARCHITECTS</p>									
<p style="font-size: 8px;">ROOF PLAN - WEST - NEW WORK</p> <p style="font-size: 8px;">ROOF REPLACEMENT: NORTH HARFORD HIGH SCHOOLS HARFORD COUNTY PUBLIC SCHOOLS PYLESVILLE, MARYLAND 21132</p>										
<table border="1" style="width: 100%; border-collapse: collapse; font-size: 8px;"> <tr> <td style="width: 50%;">REV. NO.</td> <td style="width: 50%;">DATE</td> </tr> <tr> <td>2 ADDENDUM NO. 2</td> <td>04/08/2026</td> </tr> </table>			REV. NO.	DATE	2 ADDENDUM NO. 2	04/08/2026				
REV. NO.	DATE									
2 ADDENDUM NO. 2	04/08/2026									
<table border="1" style="width: 100%; border-collapse: collapse; font-size: 8px;"> <tr> <td style="width: 50%;">DRAWN BY</td> <td style="width: 50%;">ASD</td> </tr> <tr> <td>PROJECT NO.</td> <td>25097</td> </tr> <tr> <td>SHEET NO.</td> <td>E2.0A</td> </tr> <tr> <td>DATE</td> <td>03/15/2026</td> </tr> </table>			DRAWN BY	ASD	PROJECT NO.	25097	SHEET NO.	E2.0A	DATE	03/15/2026
DRAWN BY	ASD									
PROJECT NO.	25097									
SHEET NO.	E2.0A									
DATE	03/15/2026									

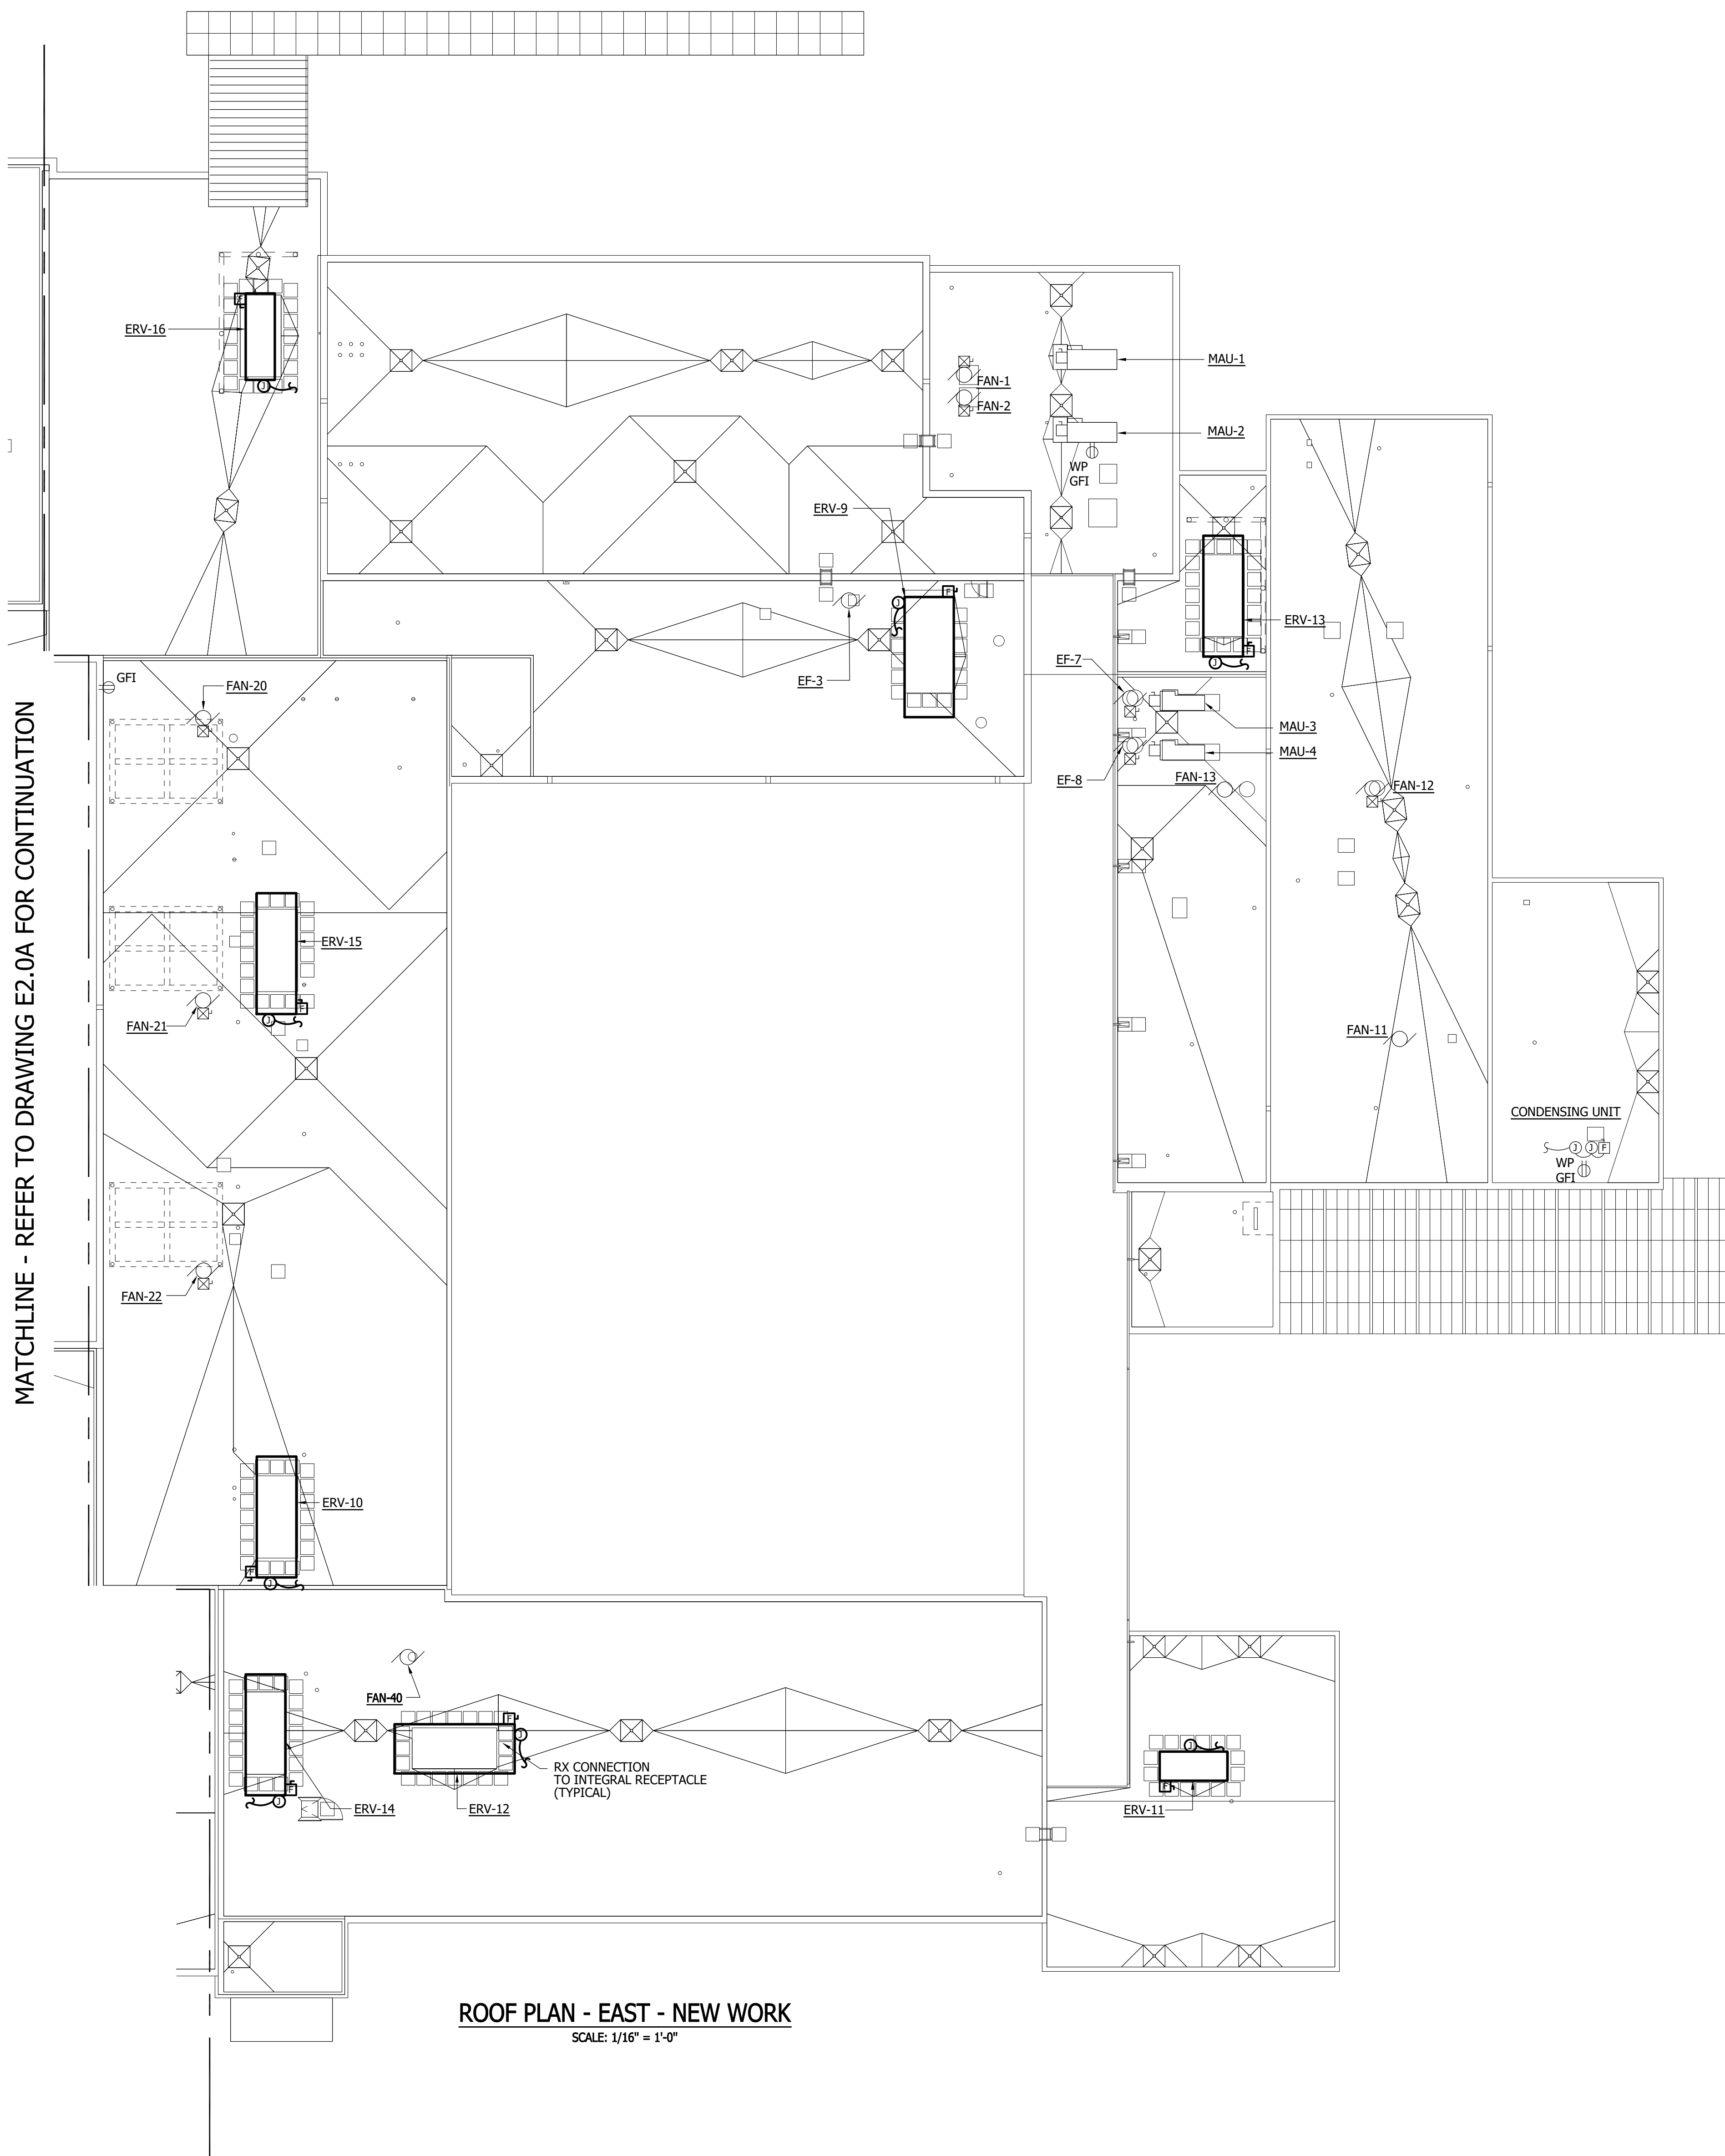


ROOF PLAN - EAST - NEW WORK
SCALE: 1/16" = 1'-0"

MATCHLINE - REFER TO DRAWING E2.0A FOR CONTINUATION

DRAWING NOTES:


- REFER TO MECHANICAL EQUIPMENT CONNECTION SCHEDULE, DRAWING E6.4, FOR ADDITIONAL INFORMATION.
- MAKE CONNECTION TO RECEPTACLE INTEGRAL IN ERV UNITS FROM EXISTING MAINTAINED CIRCUIT AS REQUIRED. REFER TO DEMOLITION DRAWINGS.

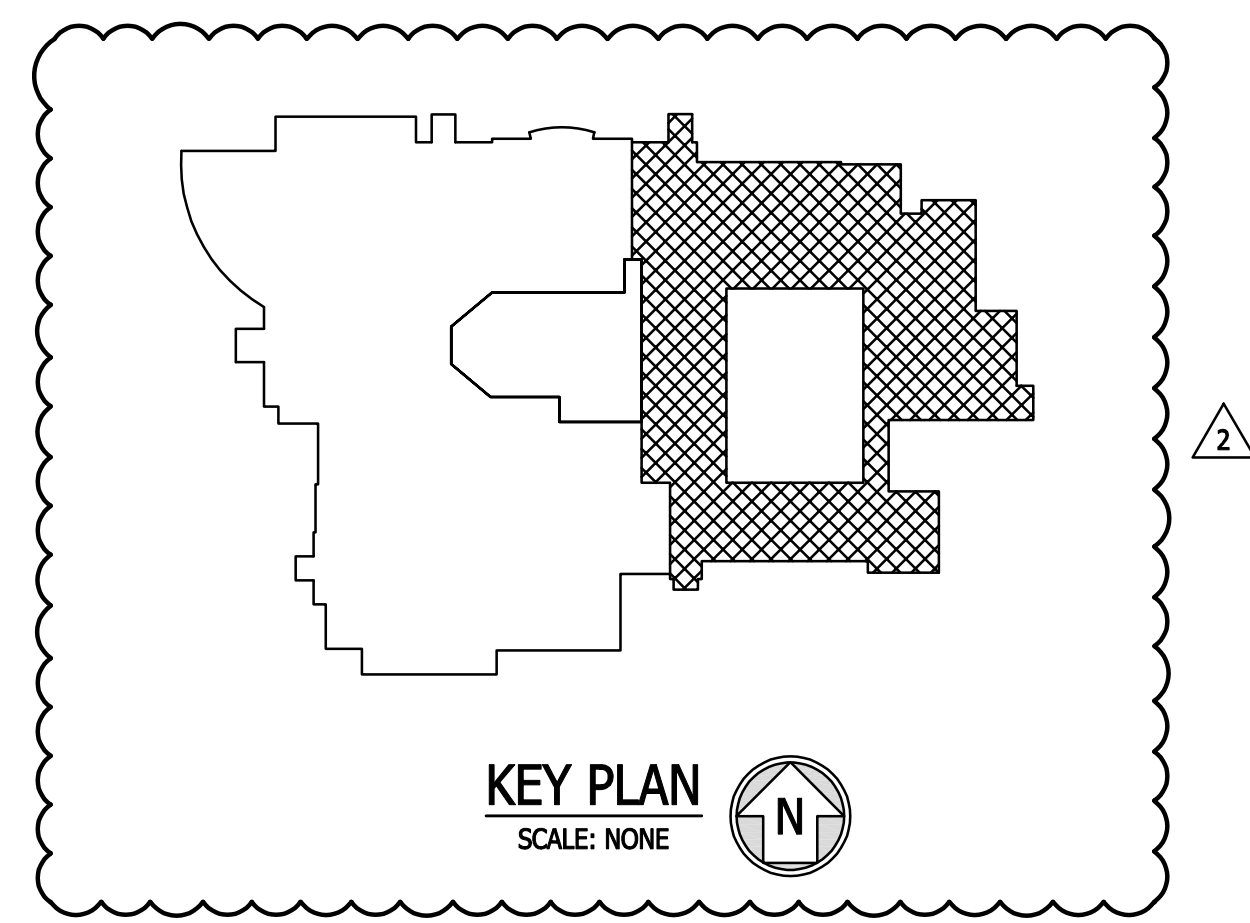

Gilbert Architects retains all intellectual property interests in the data and information on these drawings. It is not to be reproduced, distributed, or otherwise make use of the data or information without the written permission of Gilbert Architects.

Gipe Associates, Inc.
CONSULTING ENGINEERS
www.gipe-inc.com
1220 Oak Ridge Road, Suite 223
Annapolis, Maryland 21403
P: 410.832.2420
F: 410.832.2400
W.D. # 25097

THIS DRAWING AND ALL ASSOCIATED CONTRACTS ARE THE PROPERTY OF GIPE ASSOCIATES, INC. AND SHALL NOT BE REPRODUCED OR RELEASED IN ANY MANNER WITHOUT THE WRITTEN PERMISSION OF GIPE ASSOCIATES, INC. Copyright © 2022

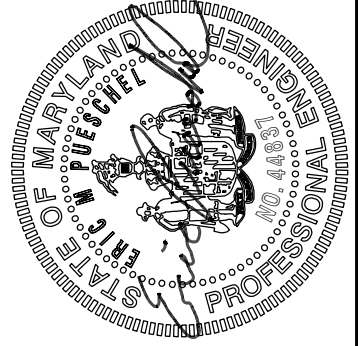

PROFESSIONAL ENGINEER
I HEREBY CERTIFY THAT THESE DOCUMENTS WERE PREPARED BY ME OR UNDER MY CLOSE PERSONAL SUPERVISION AND THAT I AM A DULY LICENSED PROFESSIONAL ENGINEER OF THE STATE OF MARYLAND.
DATE: 12/27/2022
EXPIRATION DATE: 12/27/2027

608 North Chesapeake Street
Lansdale, PA 17603
P: 717.271.1217
F: 717.271.1218
200 Commercial Drive, Suite 401
P: 302.338.3300
F: 302.338.3300
10401 Mill Run Circle, Suite 400
Dwight Mills, MD 21117
P: 410.266.8626
F: 410.266.8626



ROOF PLAN - EAST - NEW WORK
ROOF REPLACEMENT:
NORTH HARFORD HIGH SCHOOLS
HARFORD COUNTY PUBLIC SCHOOLS
PYLESVILLE, MARYLAND 21132

REV. NO.	DATE
2 ADDENDUM NO.2	04/08/2026


DRAWN BY: ASD

PROJECT NO.: 25097


SHEET NO.:

E2.0B

DATE: 03/15/2026

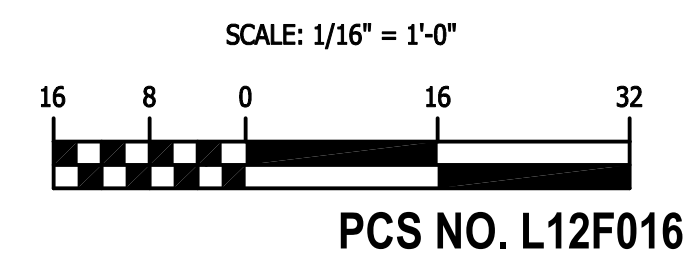


PCS NO. L12F016

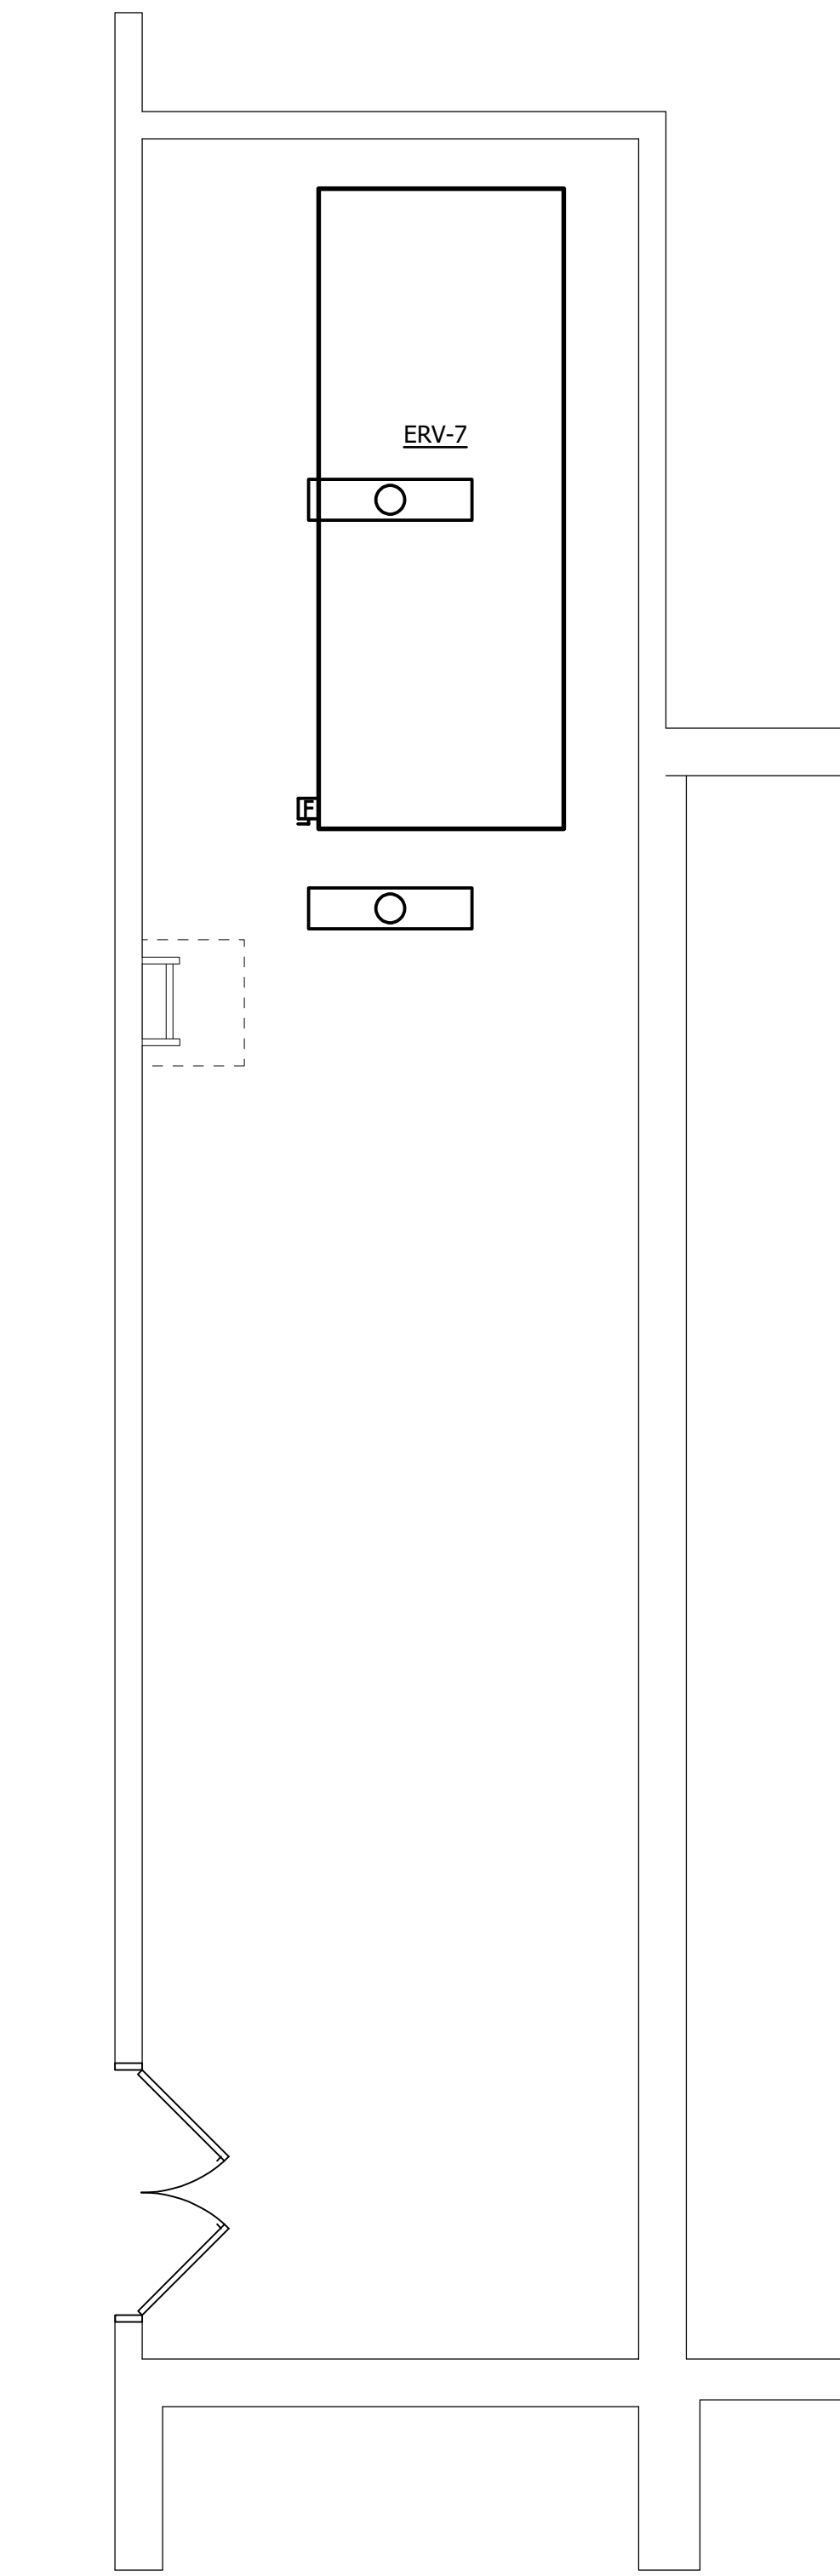


MECHANICAL ROOM - A301 - NEW WORK
SCALE: 1/4" = 1'-0"

GENERAL NOTES:

1. REFER TO MECHANICAL EQUIPMENT SCHEDULE, DWG. E6.4, FOR ADDITIONAL INFORMATION.
2. REINSTALL EXISTING CEILING MOUNTED DEVICES REMOVED TO ACCOMMODATE NEW CEILINGS/HVAC WORK AS REQUIRED. REFER TO DEMOLITION DRAWINGS.

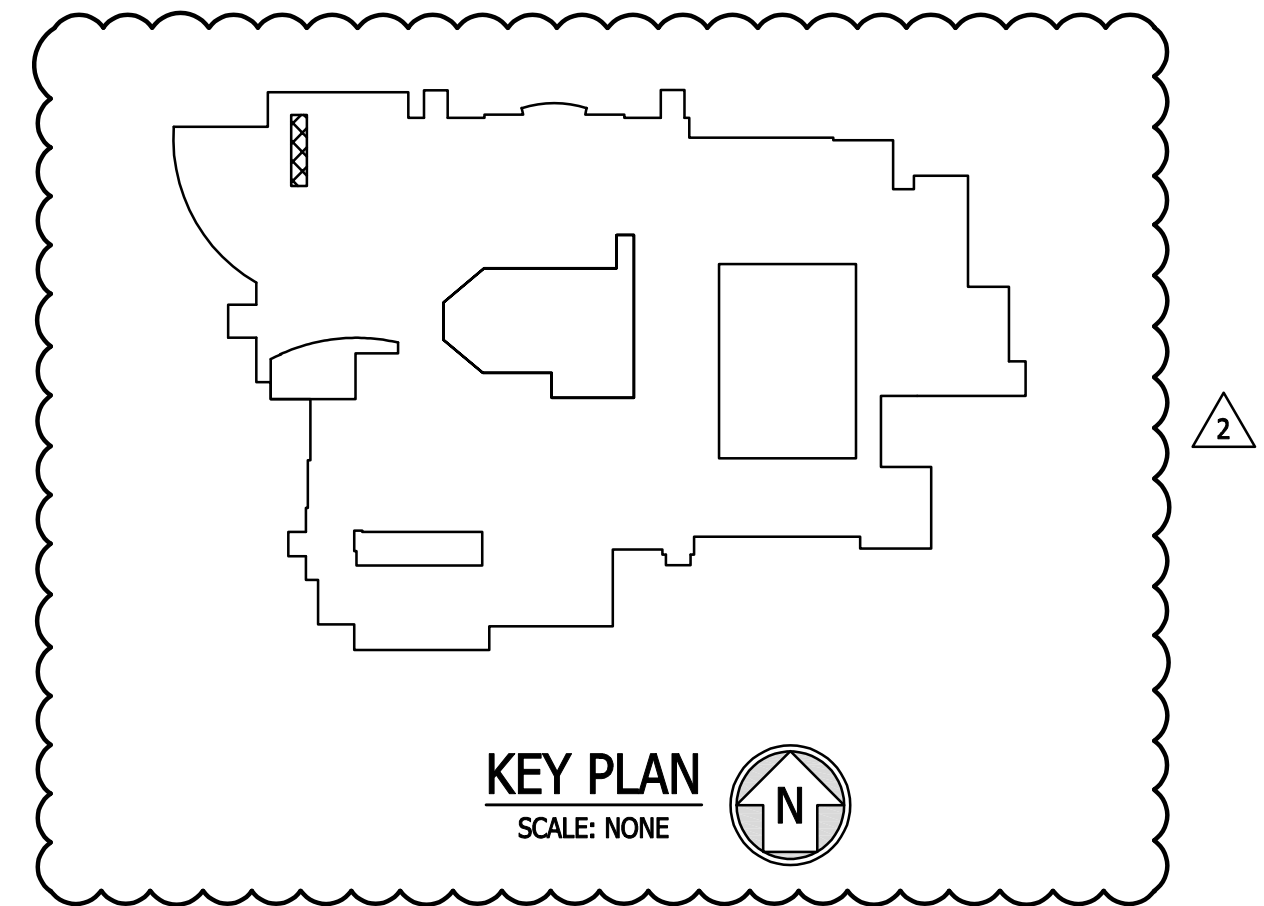

KEY PLAN
SCALE: NONE

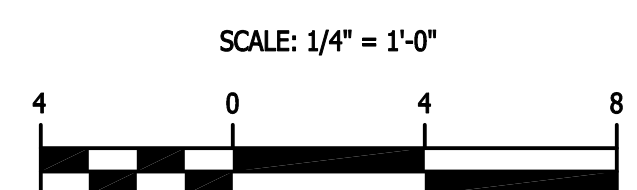


PCS NO. L12F016

<p>PROFESSIONAL SEAL</p> <p>STATE OF MARYLAND</p> <p>PROFESSIONAL ENGINEER</p> <p>NO. 25097</p> <p>DATE: 12/27/2027</p>	
<p>GILBERT ARCHITECTS</p> <p>108 North Chesapeake Street Laneshaw, PA 17603 P: 717.281.1077</p> <p>200 Commonwealth Drive, Suite 401 Pylesville, MD 21152 P: 410.392.3838</p> <p>10401 Mill Run Circle, Suite 400 Dumfries, MD 21117 P: 410.392.8266</p>	
<p>ROOF REPLACEMENT: NORTH HARFORD HIGH SCHOOL HARFORD COUNTY PUBLIC SCHOOLS PYLESVILLE, MARYLAND 21152</p>	
<p>PART PLAN - MECHANICAL ROOM - A301 - NEW WORK</p>	
<p>DATE: 03/15/2026</p>	<p>2 ADDENDUM NO. 2</p>
<p>DRAWN BY: ASD</p>	<p>PROJECT NO.: 25097</p>
<p>SHEET NO.: E.2.1</p>	
<p>DATE: 03/15/2026</p>	<p>DATE: 03/15/2026</p>

Gilbert Architects retains all intellectual property interests in the data and information on these drawings. It is not to be reproduced, distributed, or otherwise make use of the data or information without the written permission of Gilbert Architects.

Gipe Associates, Inc.
CONSULTING ENGINEERS
www.gipe-inc.com
1220 East Joyce Road, Suite 223
Baltimore, Maryland 21286
P: 410.532.2420
F: 410.532.2686
W.D. # 25097

*THIS DRAWING, AND ALL DESIGN AND CONSTRUCTION INFORMATION HEREON, IS THE PROPERTY OF Gipe Associates, Inc. AND SHALL NOT BE LOANED OR REPRODUCED IN ANY MANNER WITHOUT THE WRITTEN PERMISSION OF Gipe Associates, Inc. Copyright © 2025


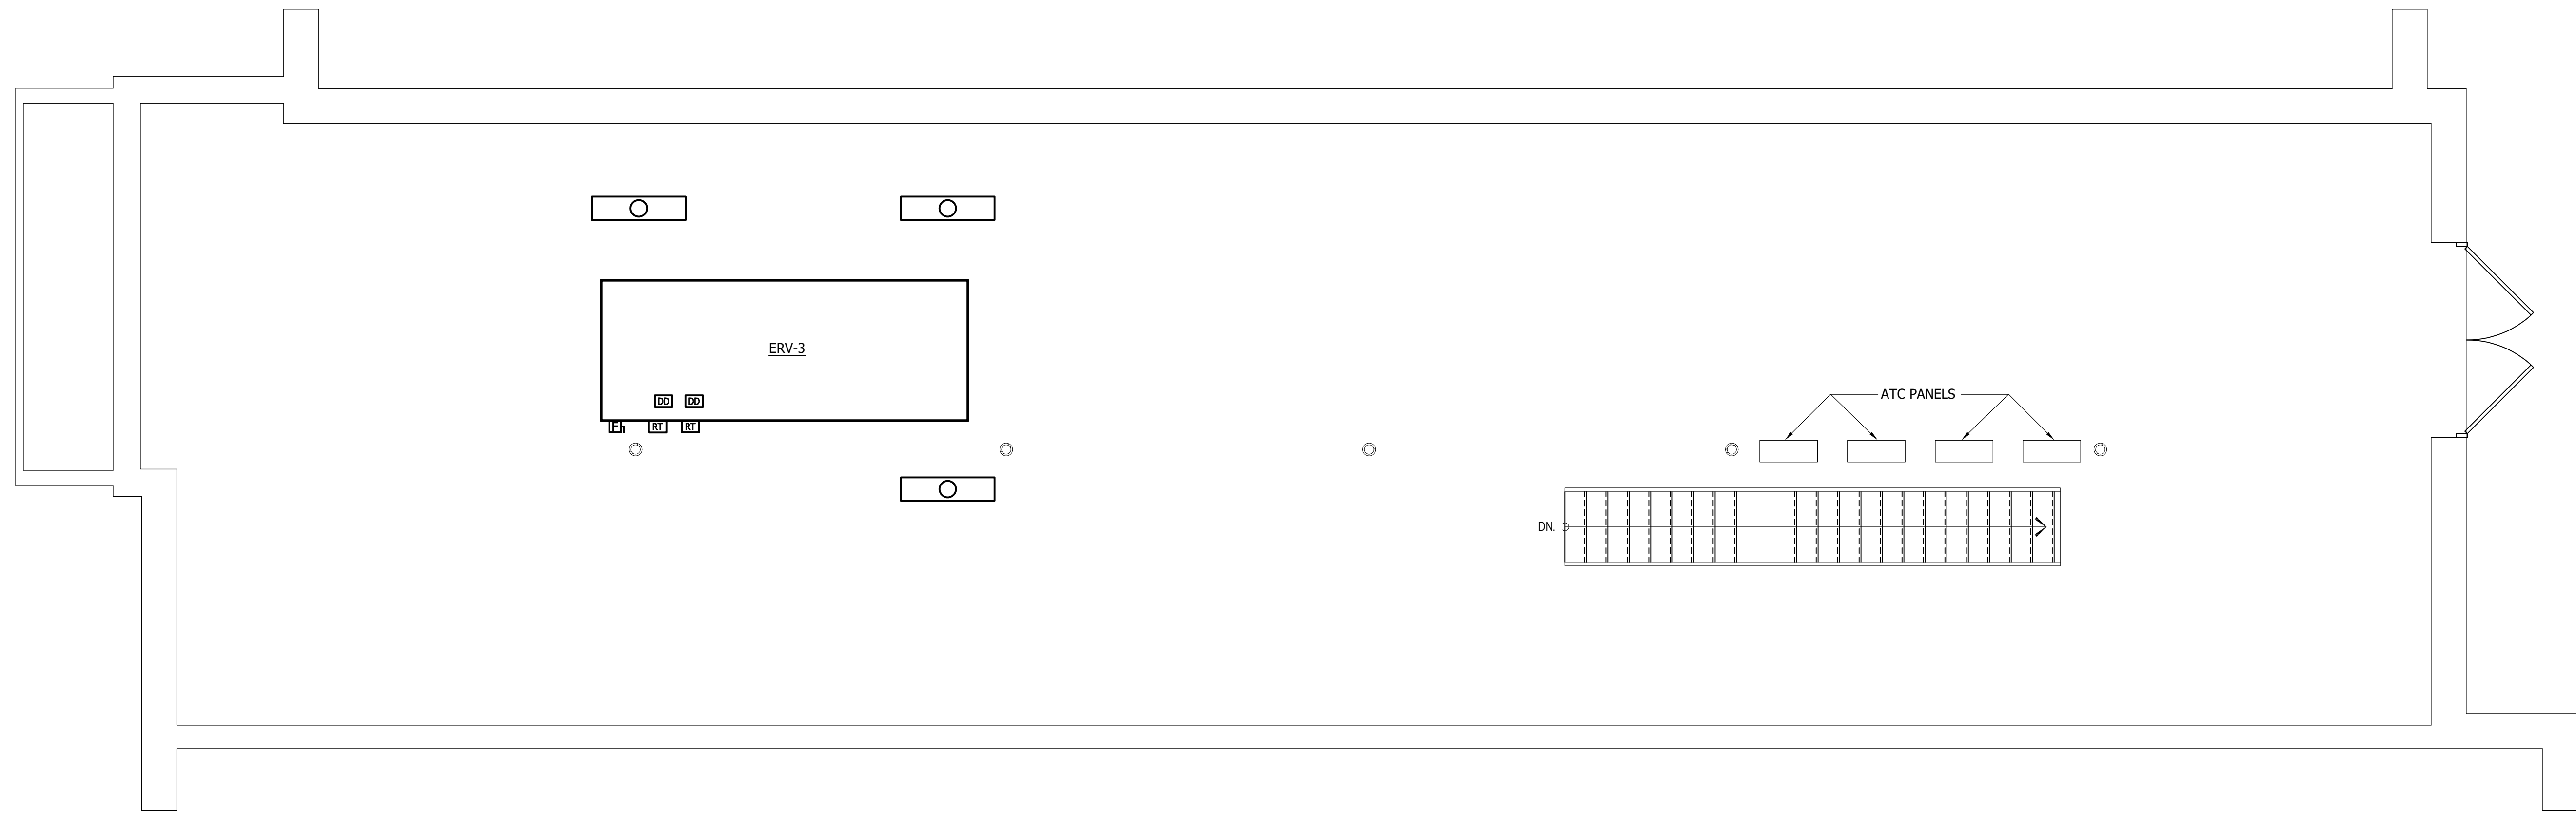


MECHANICAL ROOM - F214 - NEW WORK

SCALE: 1/4" = 1'-0"

GENERAL NOTES:


1. REFER TO MECHANICAL EQUIPMENT SCHEDULE, DWG. E6-4, FOR ADDITIONAL INFORMATION.
2. REINSTALL EXISTING CEILING MOUNTED DEVICES REMOVED TO ACCOMMODATE NEW CEILINGS/HVAC WORK AS REQUIRED. REFER TO DEMOLITION DRAWINGS.

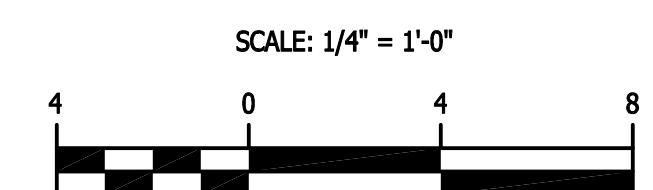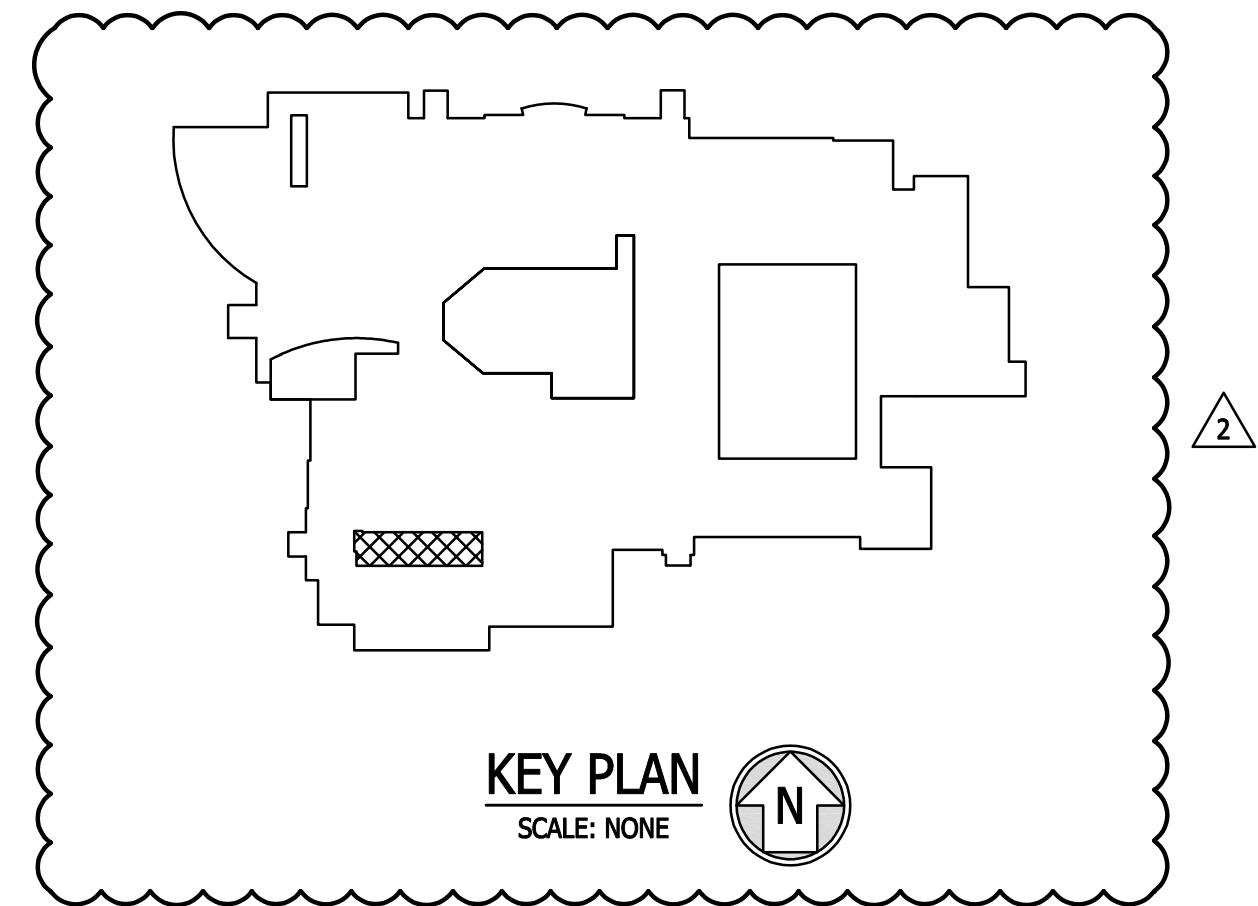

PCS NO. L12F016

Gilbert Architects retains all intellectual property interests in the data and information on these drawings. It is not to be reproduced, distributed, or otherwise make use of the data or information without the written permission of Gilbert Architects.

Gipe Associates, Inc.
CONSULTING ENGINEERS
www.gipe-inc.com
1220 East Joyce Road, Suite 222
410-832-2420
Baltimore, Maryland
W.D. # 25097
PROFESSIONAL ENGINEERS AND ARCHITECTS REGISTERED IN THE STATE OF MARYLAND
ASSOCIATES, INC. Copyright © 2022

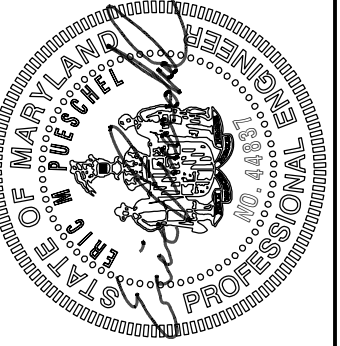

PROFESSIONAL ENGINEER
I HEREBY CERTIFY THAT
THESE DOCUMENTS WERE
PREPARED BY ME OR UNDER
MY CLOSE PERSONAL SUPERVISION
AND THAT I AM A DULY LICENSED PROFESSIONAL ENGINEER
OF THE STATE OF MARYLAND.
DATE: 03/15/2026
EXPIRATION DATE: 12/31/2027

608 North Chesapeake Street
Lanahan, PA 17603
P: 717-251-1177
200 Commonwealth Drive, Suite 401
Pylesville, MD 21152
P: 410-392-5200
10401 Mill Run Circle, Suite 400
Dumfries Hills, MD 21117
P: 410-392-5205



PART PLAN - MECHANICAL ROOM - F214 - NEW WORK
ROOF REPLACEMENT:
NORTH HARFORD HIGH SCHOOL
HARFORD COUNTY PUBLIC SCHOOLS
PYLESVILLE, MARYLAND 21152

REVISION	DATE
2. ADDENDUM NO. 2	04/08/2026


DRAWN BY: ASD

PROJECT NO.: 26587

SHEET NO.:


E2.2

DATE: 03/15/2026

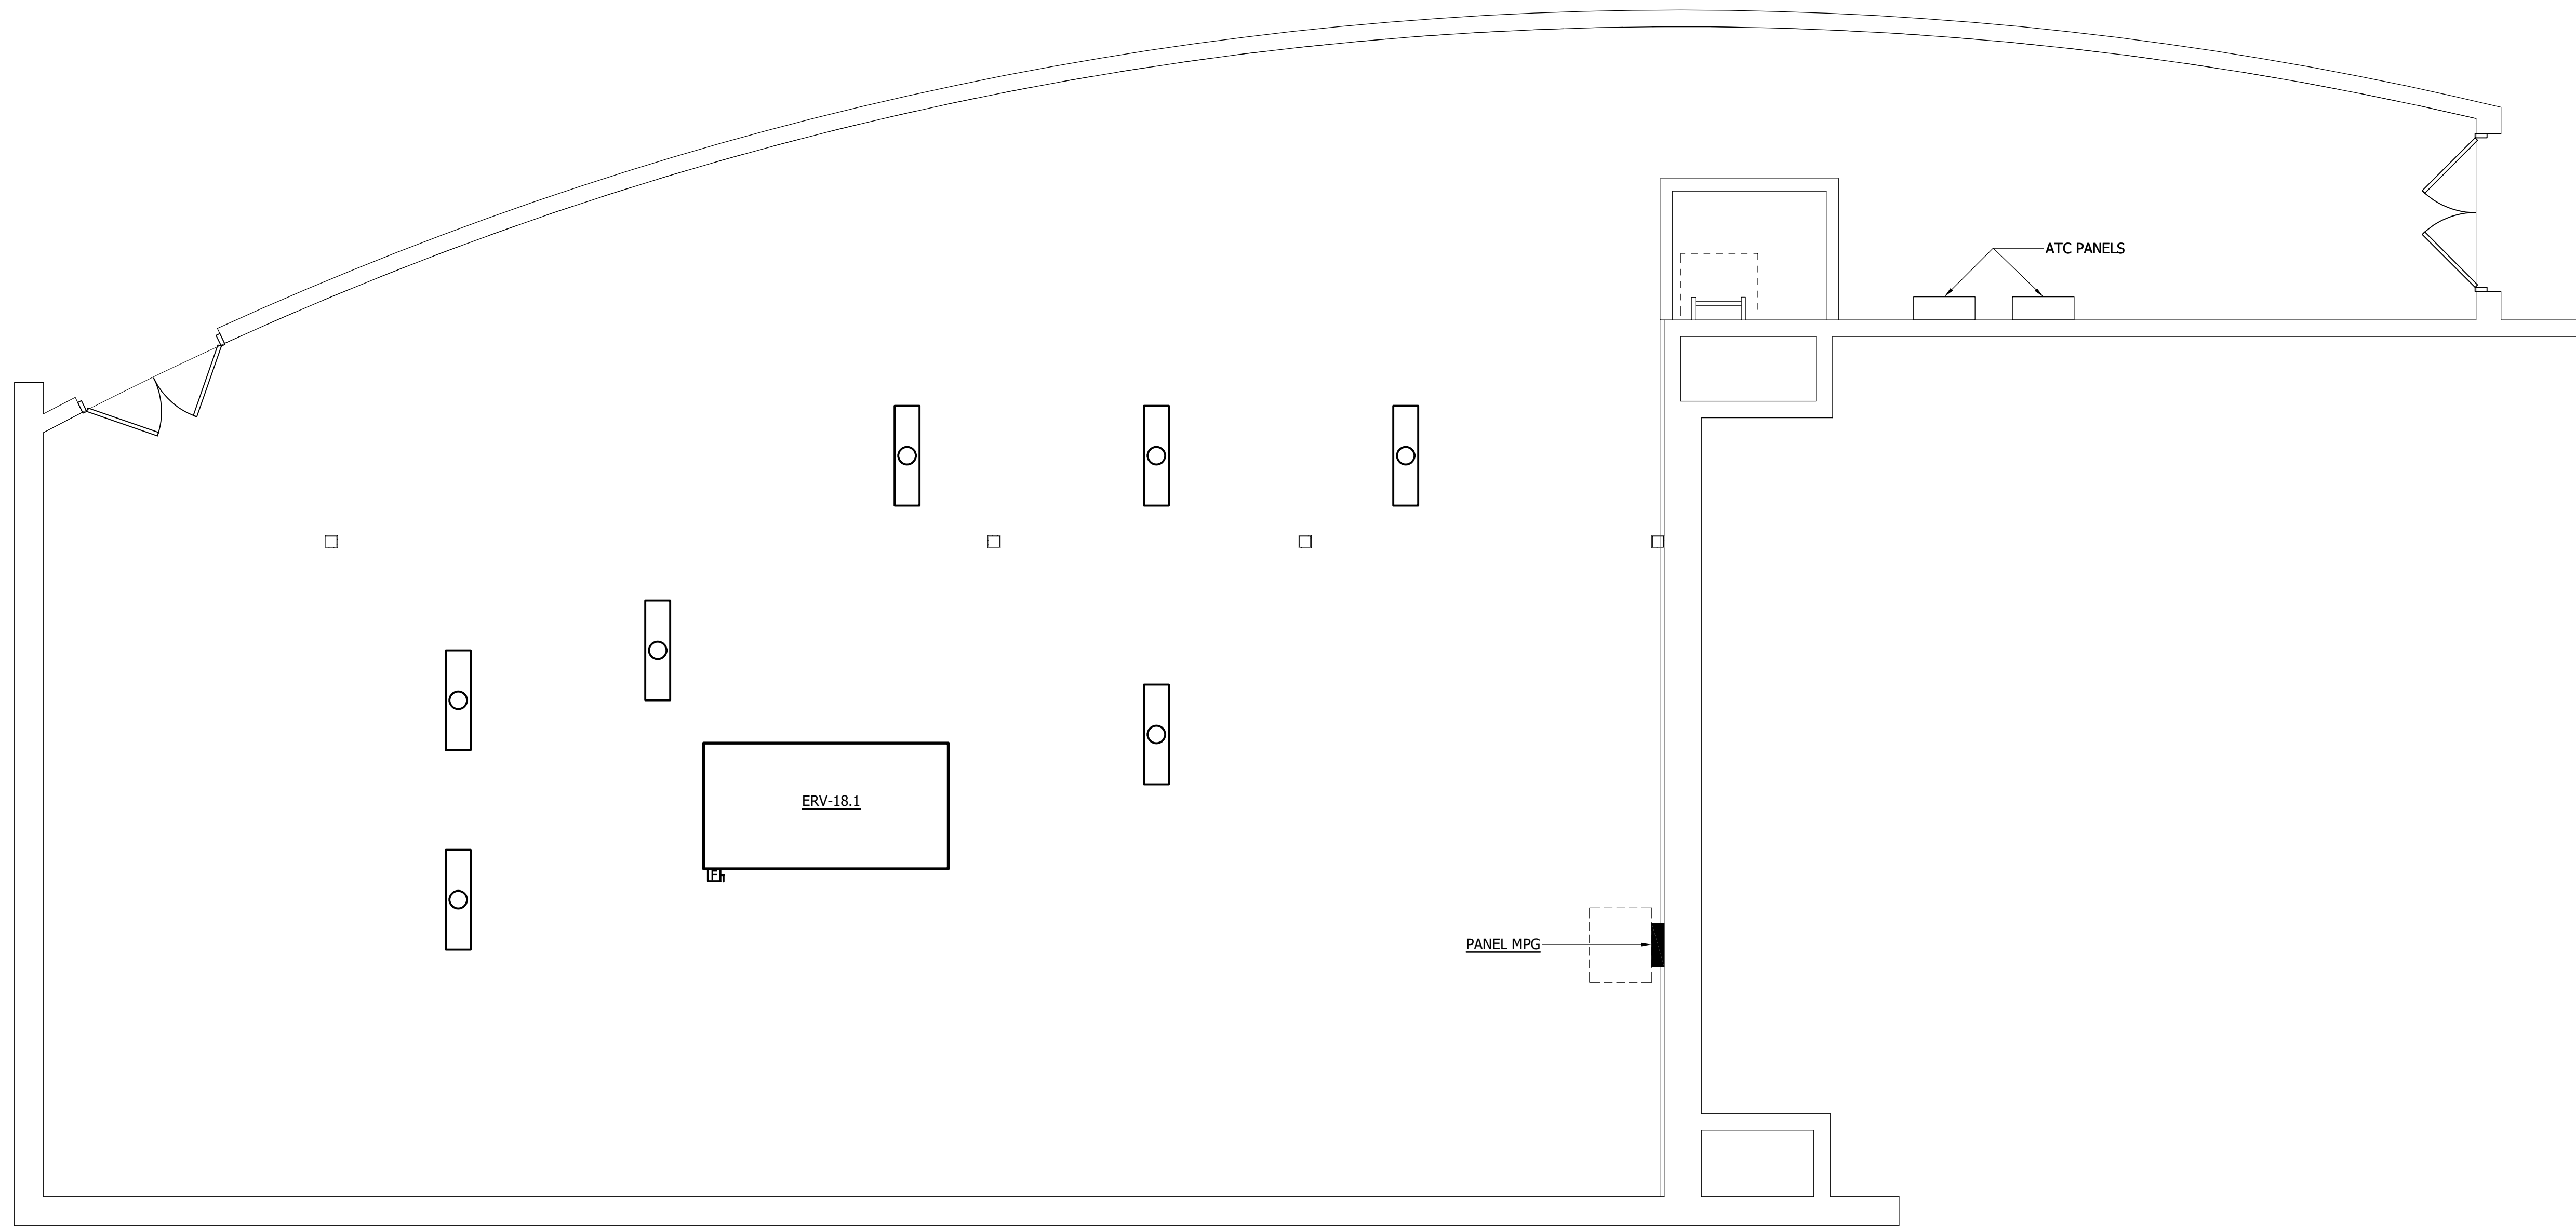

MECHANICAL ROOM - G300 - BOD MANUFACTURER

SCALE: 1/4" = 1'-0"


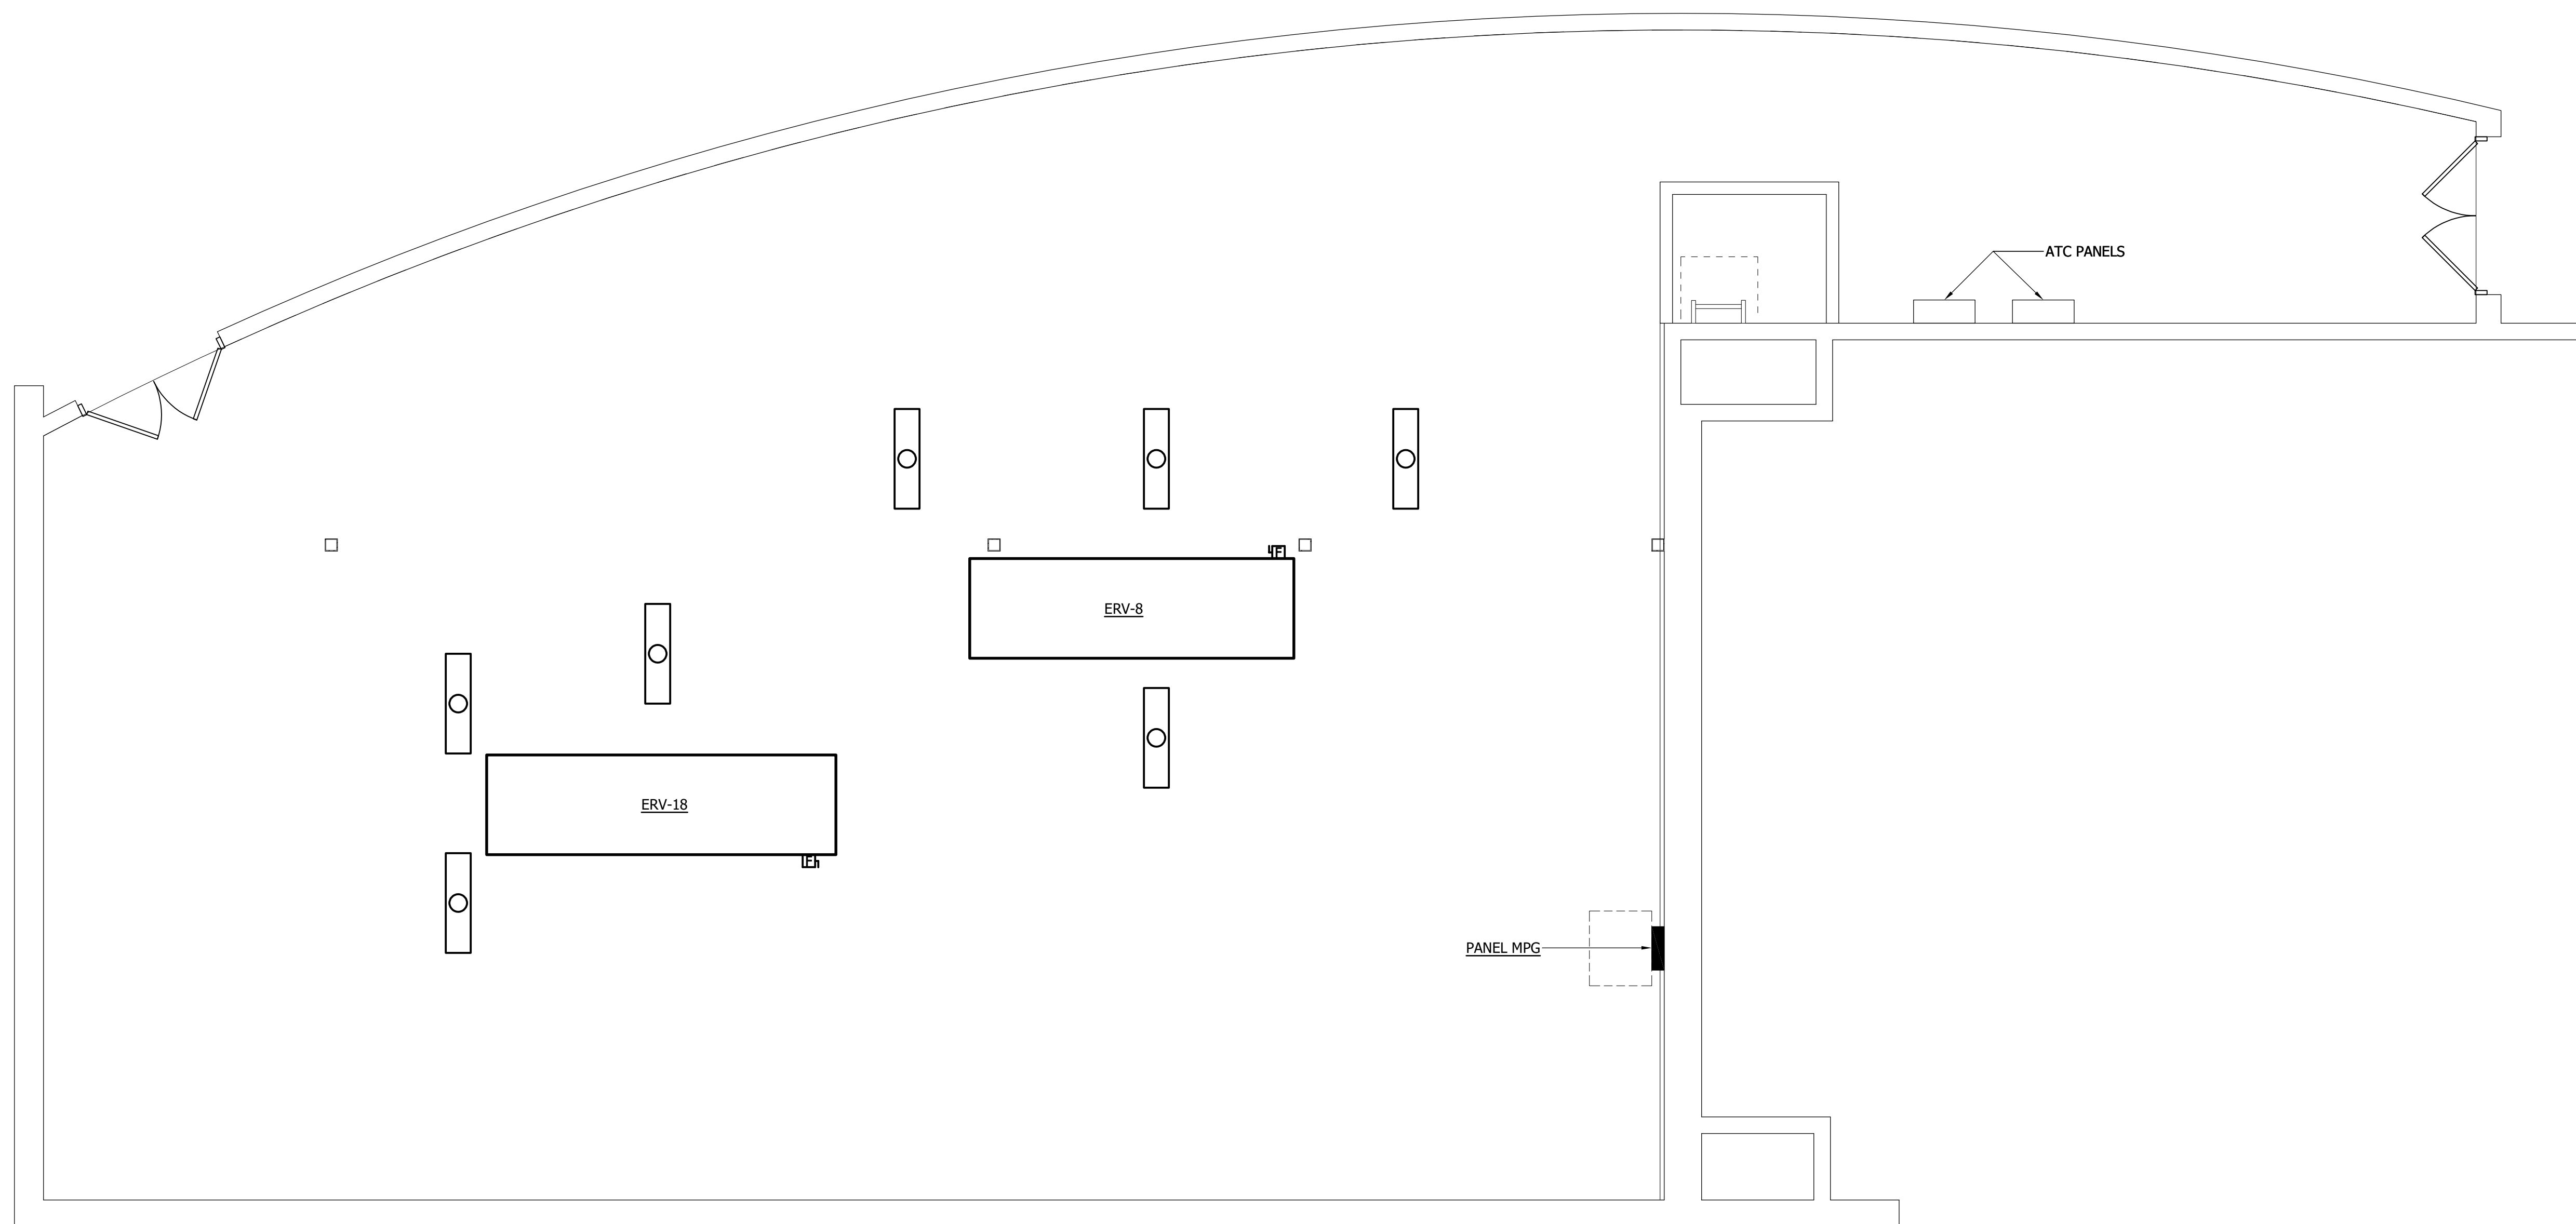


MECHANICAL ROOM - G300 - ALTERNATE MANUFACTURER

SCALE: 1/4" = 1'-0"


GENERAL NOTES:

1. REFER TO MECHANICAL EQUIPMENT SCHEDULE, DWG. E6.4, FOR ADDITIONAL INFORMATION.
2. REINSTALL EXISTING CEILING MOUNTED DEVICES REMOVED TO ACCOMMODATE NEW CEILINGS/HVAC WORK AS REQUIRED. REFER TO DEMOLITION DRAWINGS.

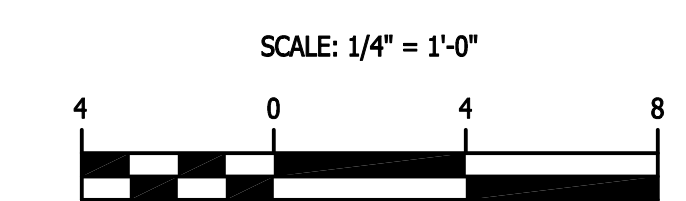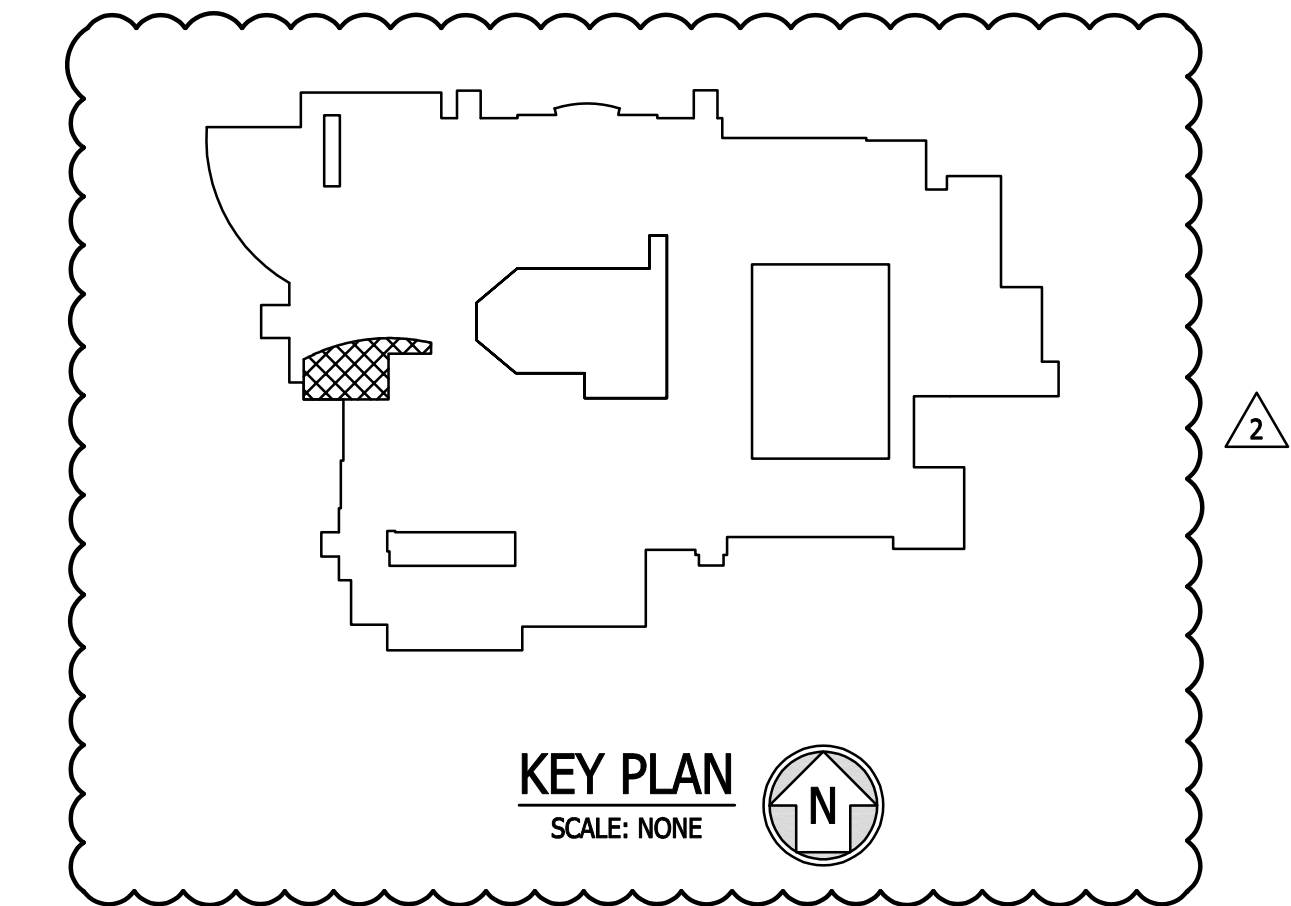


Gilbert Architects retains all intellectual property interests in the data and information on these drawings. It will not reproduce, distribute, or otherwise make use of the data or information without the written permission of Gilbert Architects.

Gipe Associates, Inc.
CONSULTING ENGINEERS
www.gipe-inc.com
1220 East Joyce Road, Suite 222
Baltimore, Maryland 21286
P: 410-332-2420
F: 410-332-2420
W: 410-332-2420

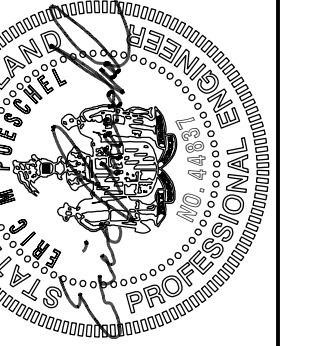

PROFESSIONAL ENGINEER
I HEREBY CERTIFY THAT
THESE DOCUMENTS WERE
PREPARED BY ME OR UNDER
MY CLOSE PERSONAL SUPERVISION
AND THAT I AM A DULY LICENSED PROFESSIONAL ENGINEER
OF THE STATE OF MARYLAND.
DATE OF SIGNATURE: 12/27/2007

608 North Chesapeake Street
Lansdale, PA 17603
P: 717-281-1177
F: 717-281-1177
200 Commonwealth Drive, Suite 401
P: 302-383-1300
F: 302-383-1300
10451 Mill Run Circle, Suite 400
Dumfries Hills, MD 21117
P: 410-266-8266
F: 410-266-8266

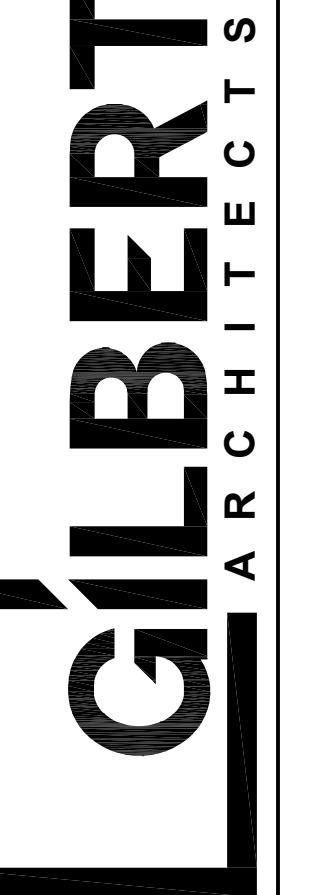

PART PLAN - MECHANICAL ROOM - G300 - NEW WORK
ROOF REPLACEMENT:
NORTH HARFORD HIGH SCHOOL
HARFORD COUNTY PUBLIC SCHOOLS
PYLESVILLE, MARYLAND 21132

REVISION	DATE
2 ADDENDUM NO.2	04/08/2026
DRAWN BY	ASD
PROJECT NO.	25097
SHEET NO.	E2.3
DATE	03/15/2026